

NOTES:

SUBJECT TO STATUTORY CONSENTS
SUBJECT TO SURVEY


BASED ON OS MAP REPRODUCED BY PERMISSION OF
CONTROLLER OF HM STATIONARY OFFICE (c) CROWN
COPYRIGHT

COPYRIGHT RESERVED

DO NOT SCALE THIS DRAWING

DO NOT USE ELECTRONIC VERSIONS OF THIS DRAWING TO
DETERMINE DIMENSIONS UNLESS SPECIFICALLY
AUTHORISED BY MICHAEL SPARKS ASSOCIATES

IF USING AN ELECTRONIC VERSION OF THIS DRAWING
FIGURED DIMENSIONS TAKE PRECEDENCE AND NOTIFY
MICHAEL SPARKS ASSOCIATES OF ANY DISCREPANCIES

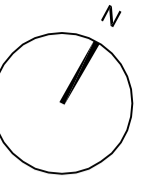

ENSURE SEALING OF ALL JUNCTIONS TO COMPLY WITH PART L.


U-Values:
Roof: 0.25
Floors: 0.25
Walls: 0.35
Glazing: 1.50

NOTE:
ROOF AND WALL CLADDING TO BE DESIGNED BY SPECIALIST
CONTRACTOR.
CLADDING DETAILS TO BE READ IN CONJUNCTION WITH THE
SPECIFICATION AND ALL RELEVANT BRITISH STANDARDS.
INCLUDE VAPOUR BARRIER TAPE AROUND ALL OPENINGS AND
JUNCTIONS.


ALL DIMENSIONS TO BE CHECKED ON SITE.
STEEL COLUMN SIZES TO BE CONFIRMED AND TOLERANCES TO BE AGREED.

NOTE:


MOISTURE RESISTANT PLASTERBOARD TO BE
USED THROUGHOUT WCs

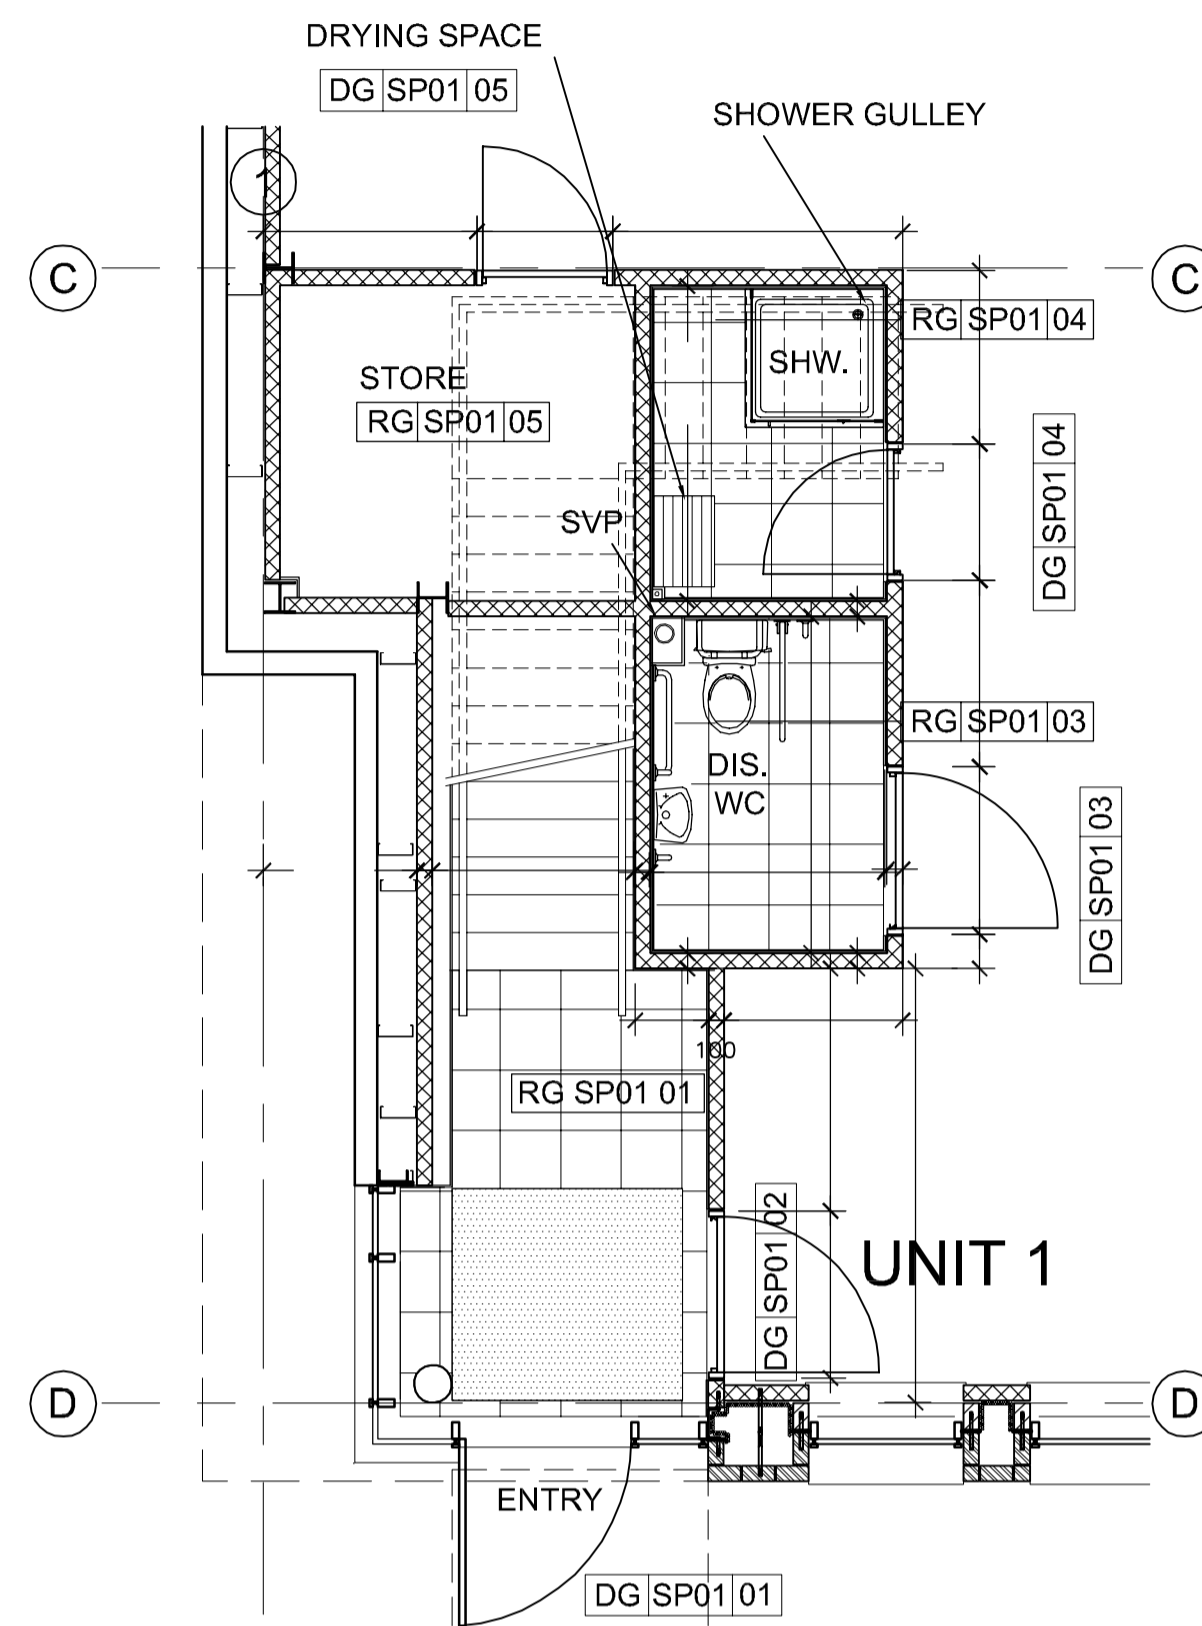


01 UNIT 1 - GF CORE PLAN
1227 1:50

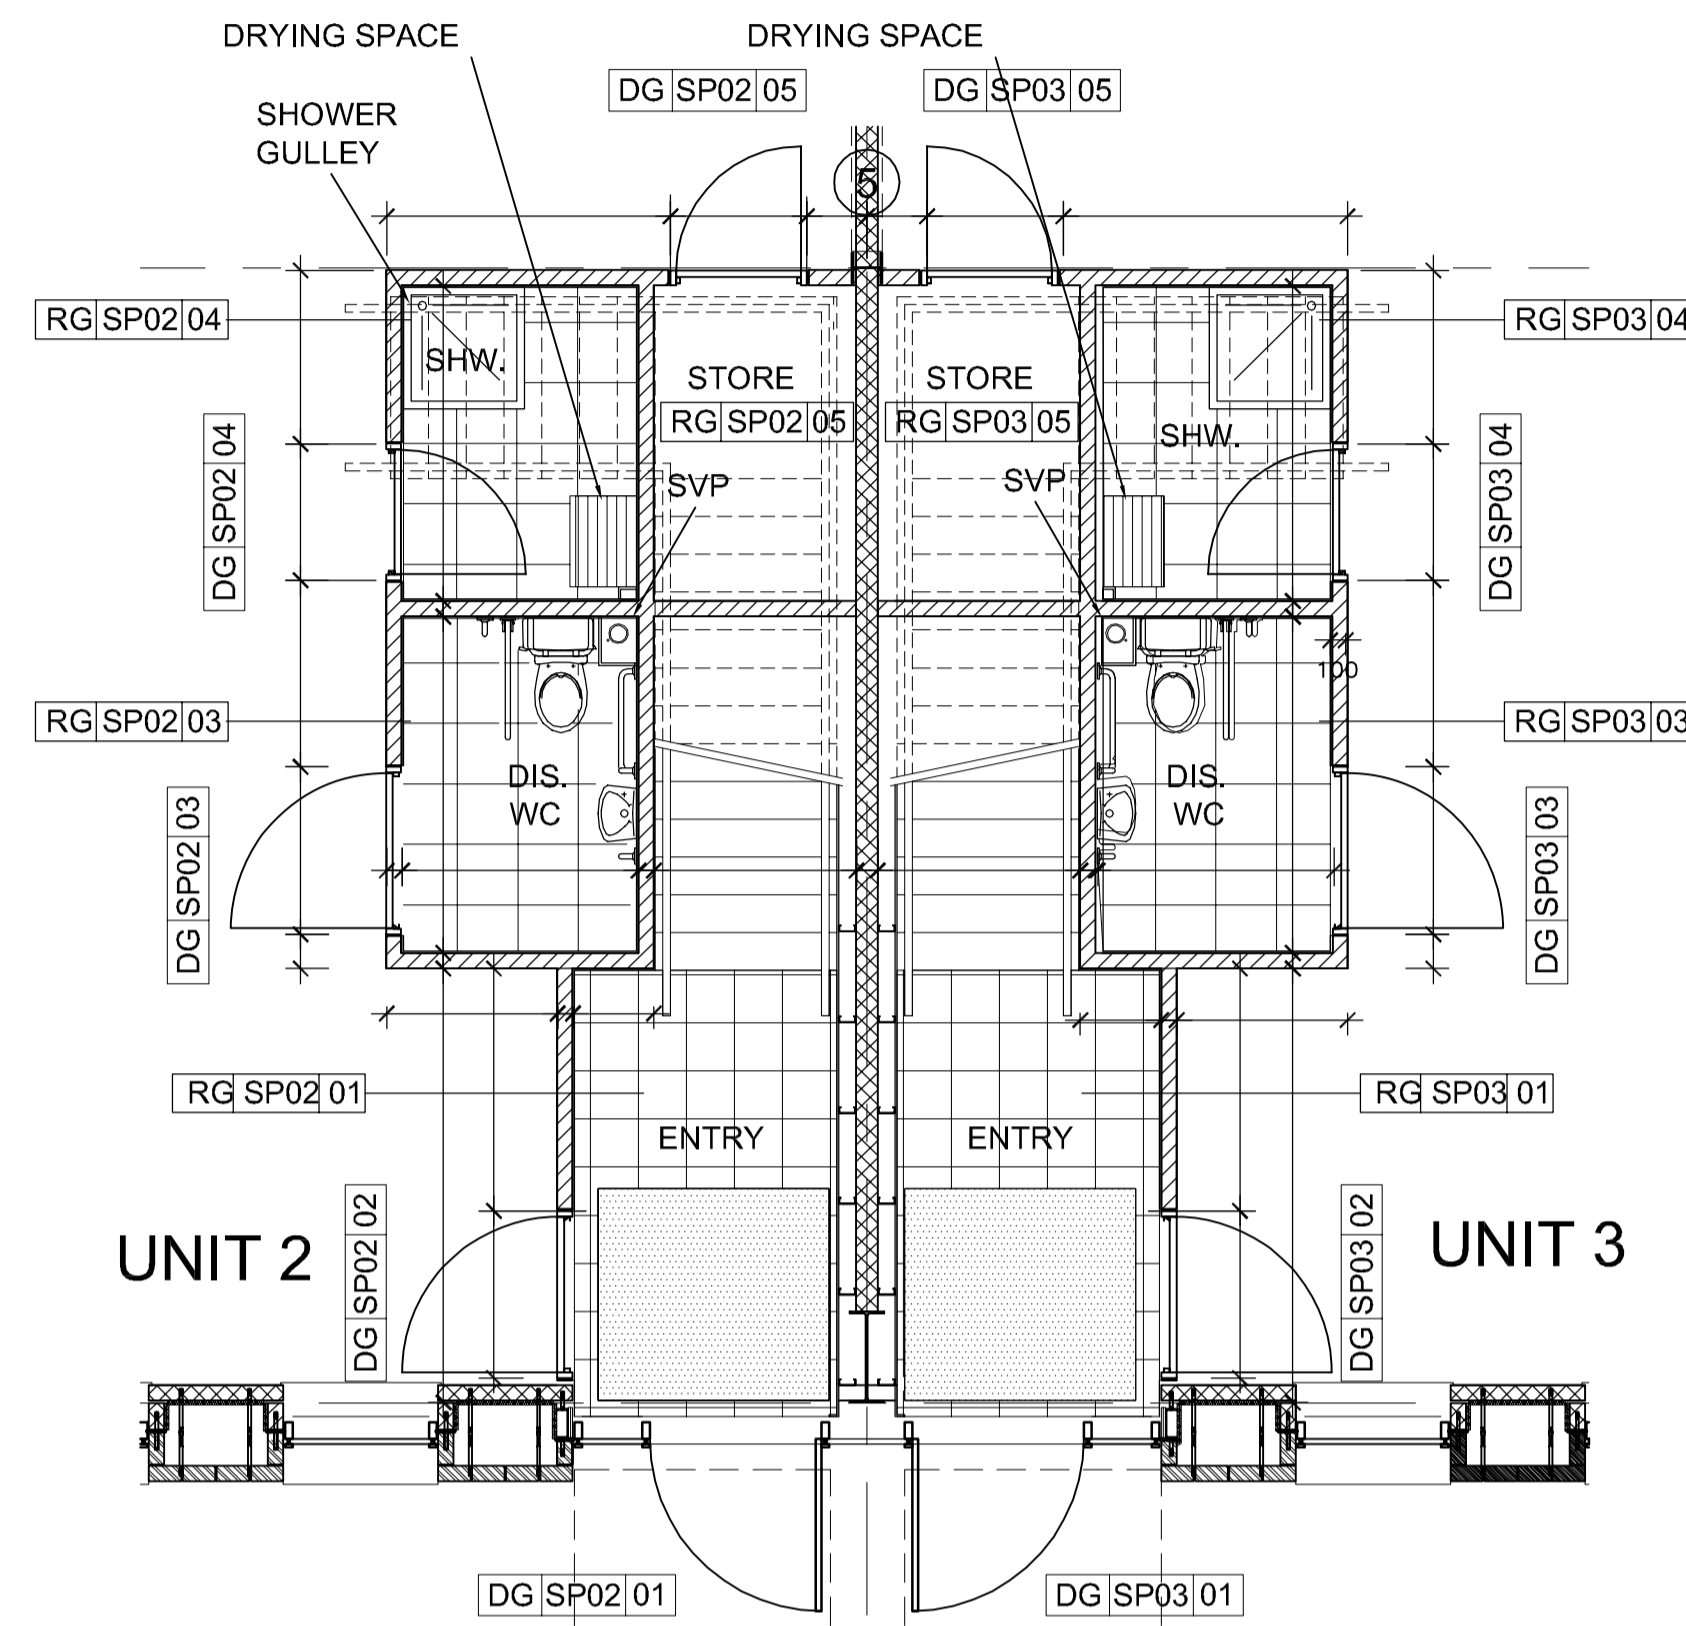


03 UNITS 2&3 - GF CORE PLAN
1227 1:50

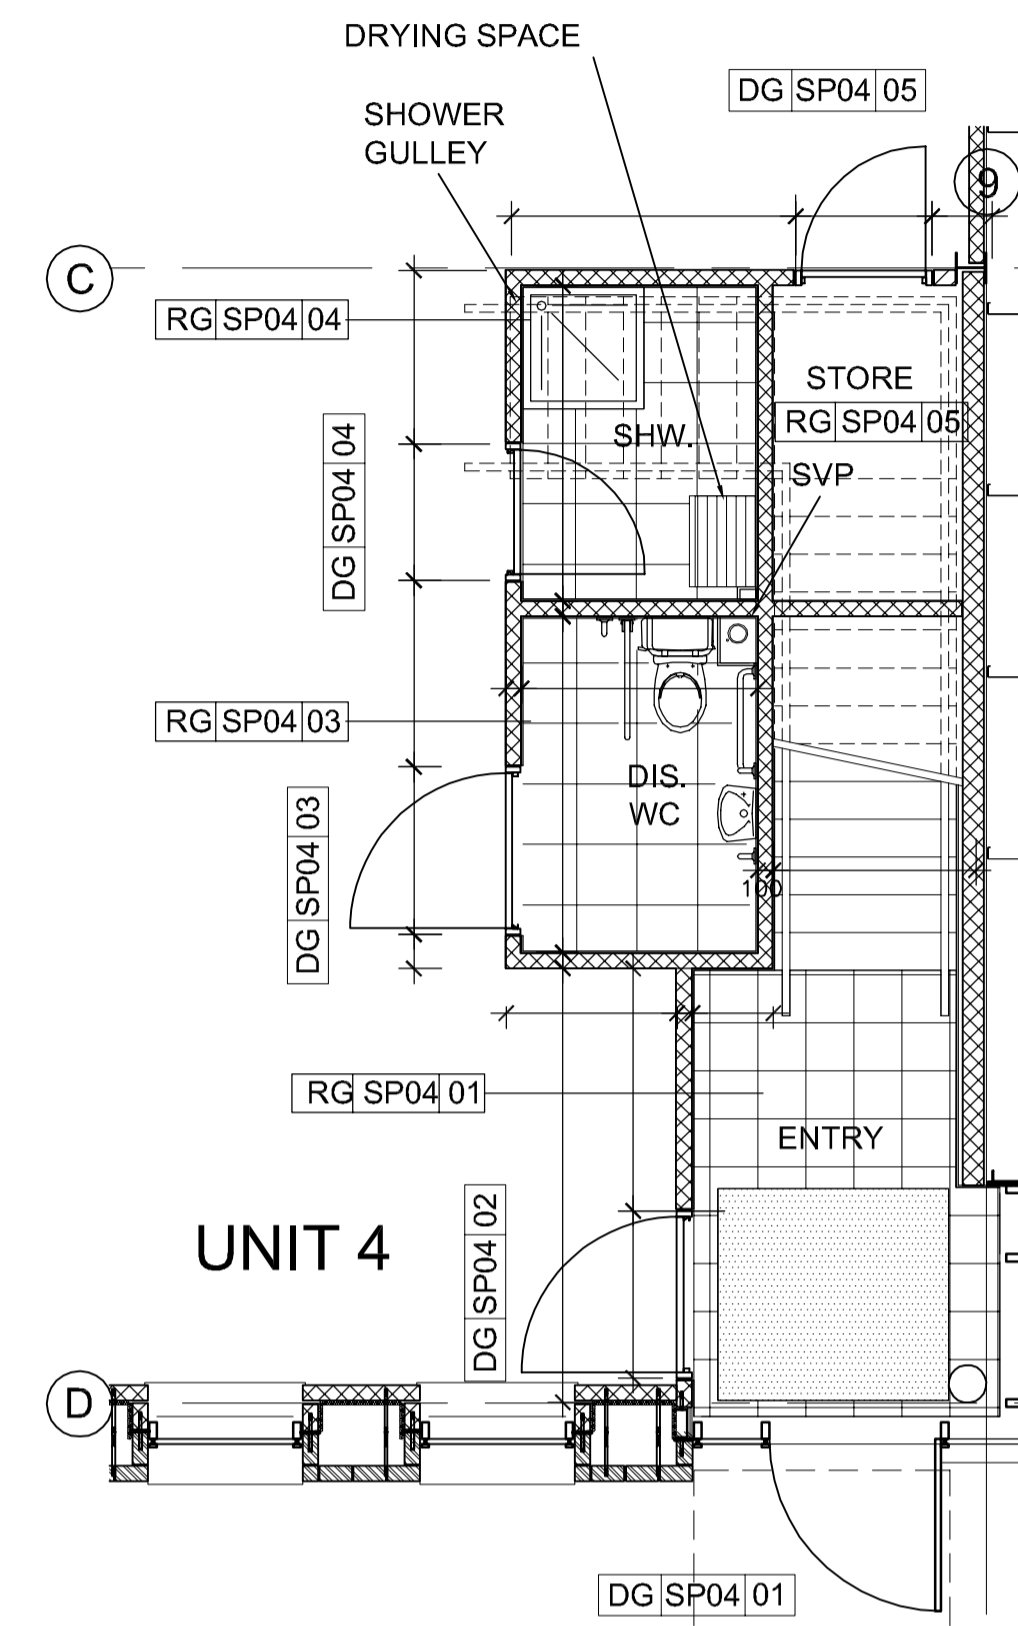


05 UNIT 4 - GF CORE PLAN
1227 1:50

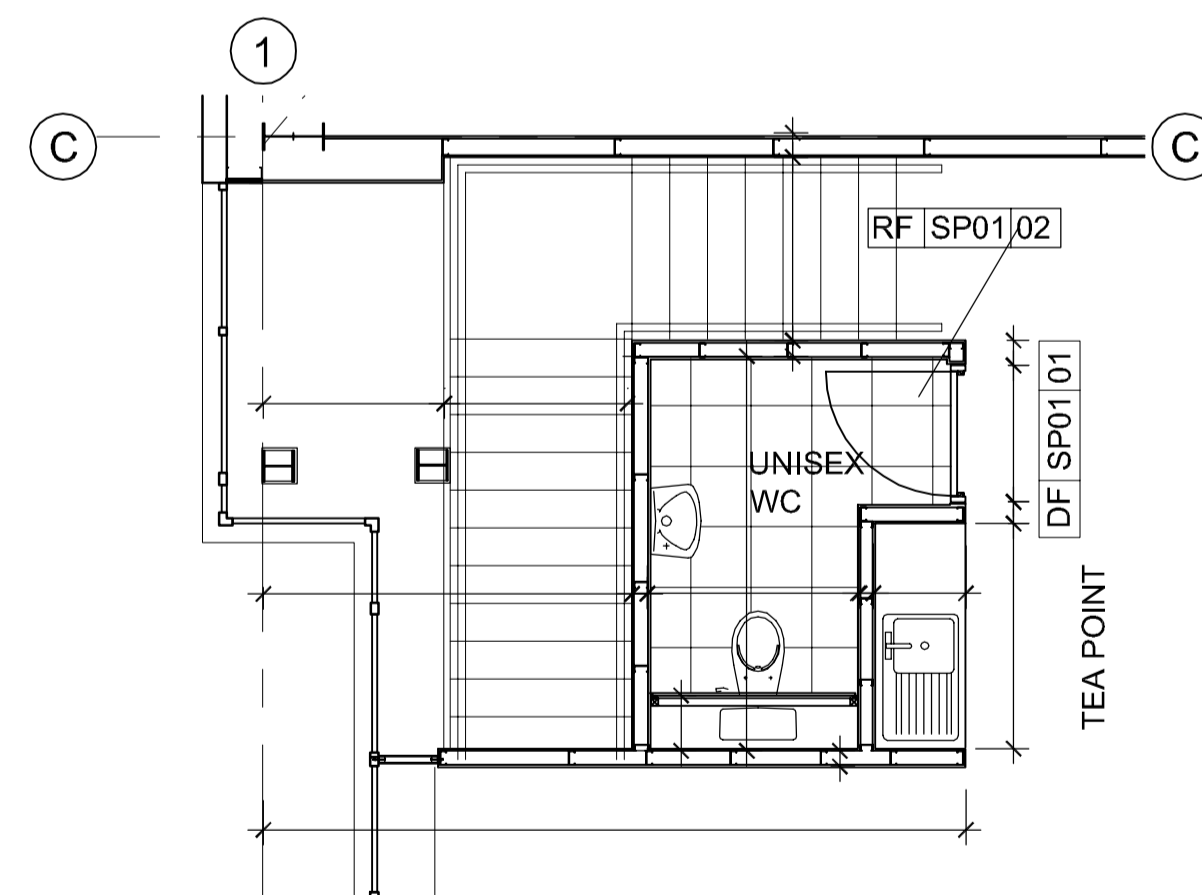

02 UNIT 1 - FF CORE PLAN
1227 1:50

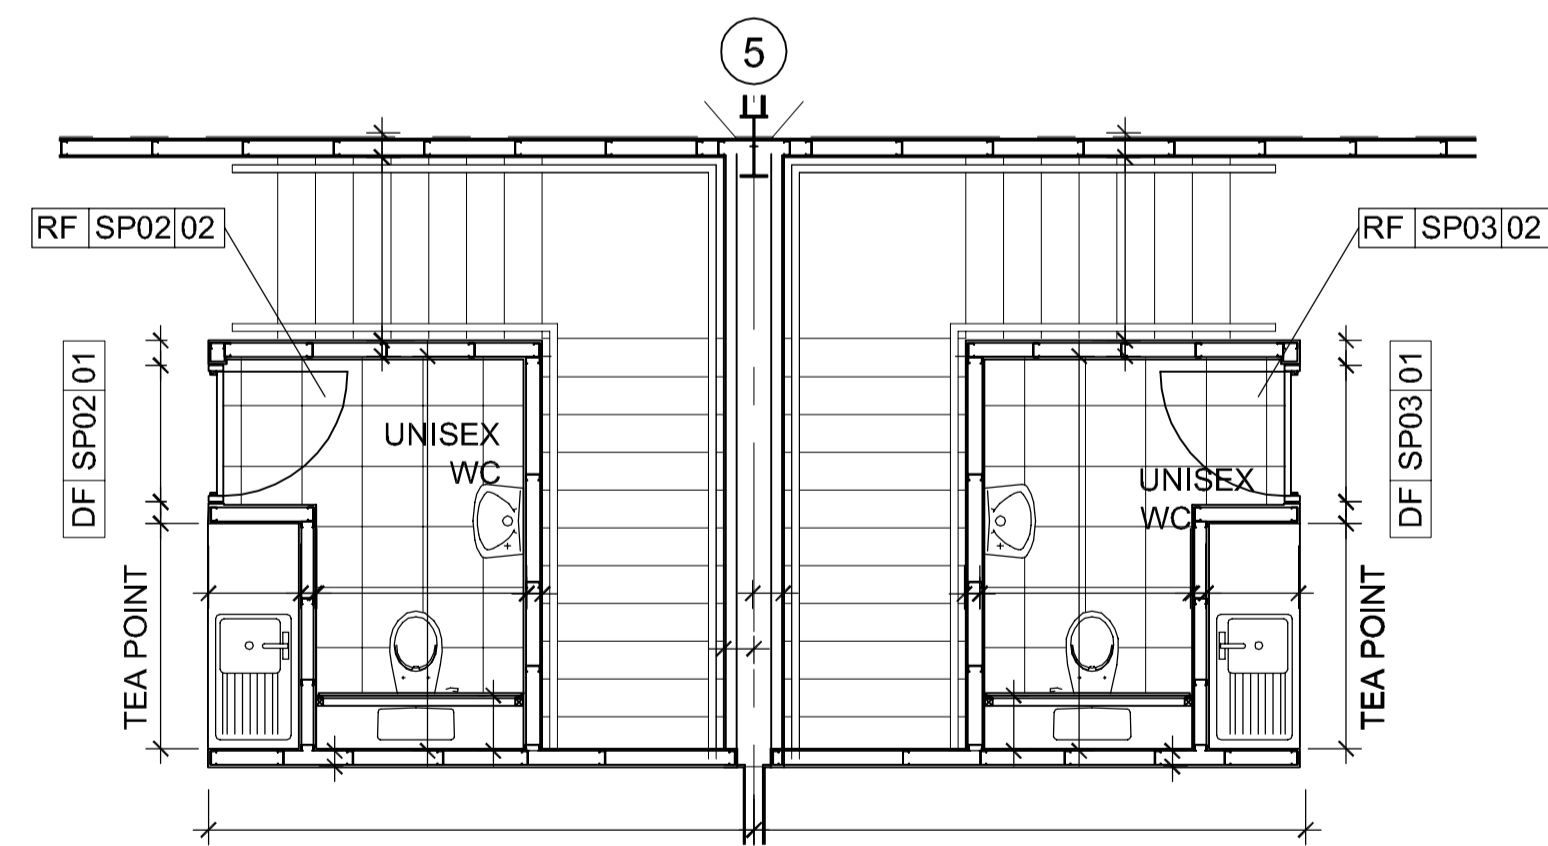

04 UNIT 2&3 - FF CORE PLAN
1227 1:50

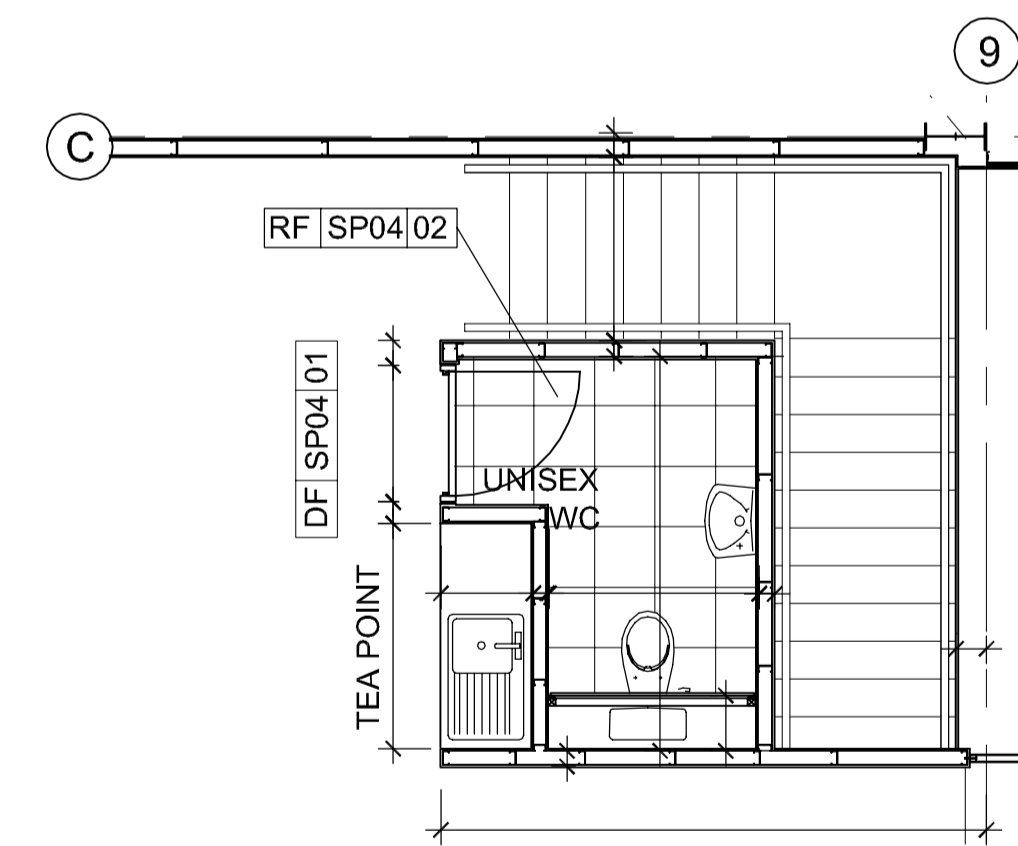


06 UNIT 4 - FF CORE PLAN
1227 1:50

AS BUILT

THIS "AS-BUILT" DRAWING IS BASED ON INFORMATION
SUPPLIED TO MICHAEL SPARKS ASSOCIATES BY MC LAREN
CONSTRUCTION AND INCORPORATES INSTRUCTIONS AND
OTHER DESIGN INFORMATION GIVEN TO MC LAREN
CONSTRUCTION DIRECTLY BY OTHERS

A	25.03.2009	Refer to sub-contractors drawings for specialist details This supercedes drawing no: 2716/EL/275 rev.J	JH	NSC
REV	DATE	NOTE	DRAW	CHK

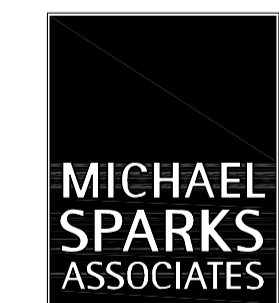

FROGMORE

CHARTERED ARCHITECTS
11 PLATO PLACE
ST. DUNGS ROAD
LONDON SW6 4TU
TELEPHONE 020 7736 6162
FAX 020 7736 3896
www.msa-architects.co.uk

TITLE
CROSSWAYS, DARTFORD
DRAWING
SCHOONER PARK UNITS 1-4
CORE PLANS
CLIENT
FROGMORE

DATE	SCALE	DRAWN
MARCH 2009	1:50 @ A1	JH
	STATUS	CHECKED
	AS BUILT	NSC

DRAWING NUMBER
2716 / AB / 1227A