
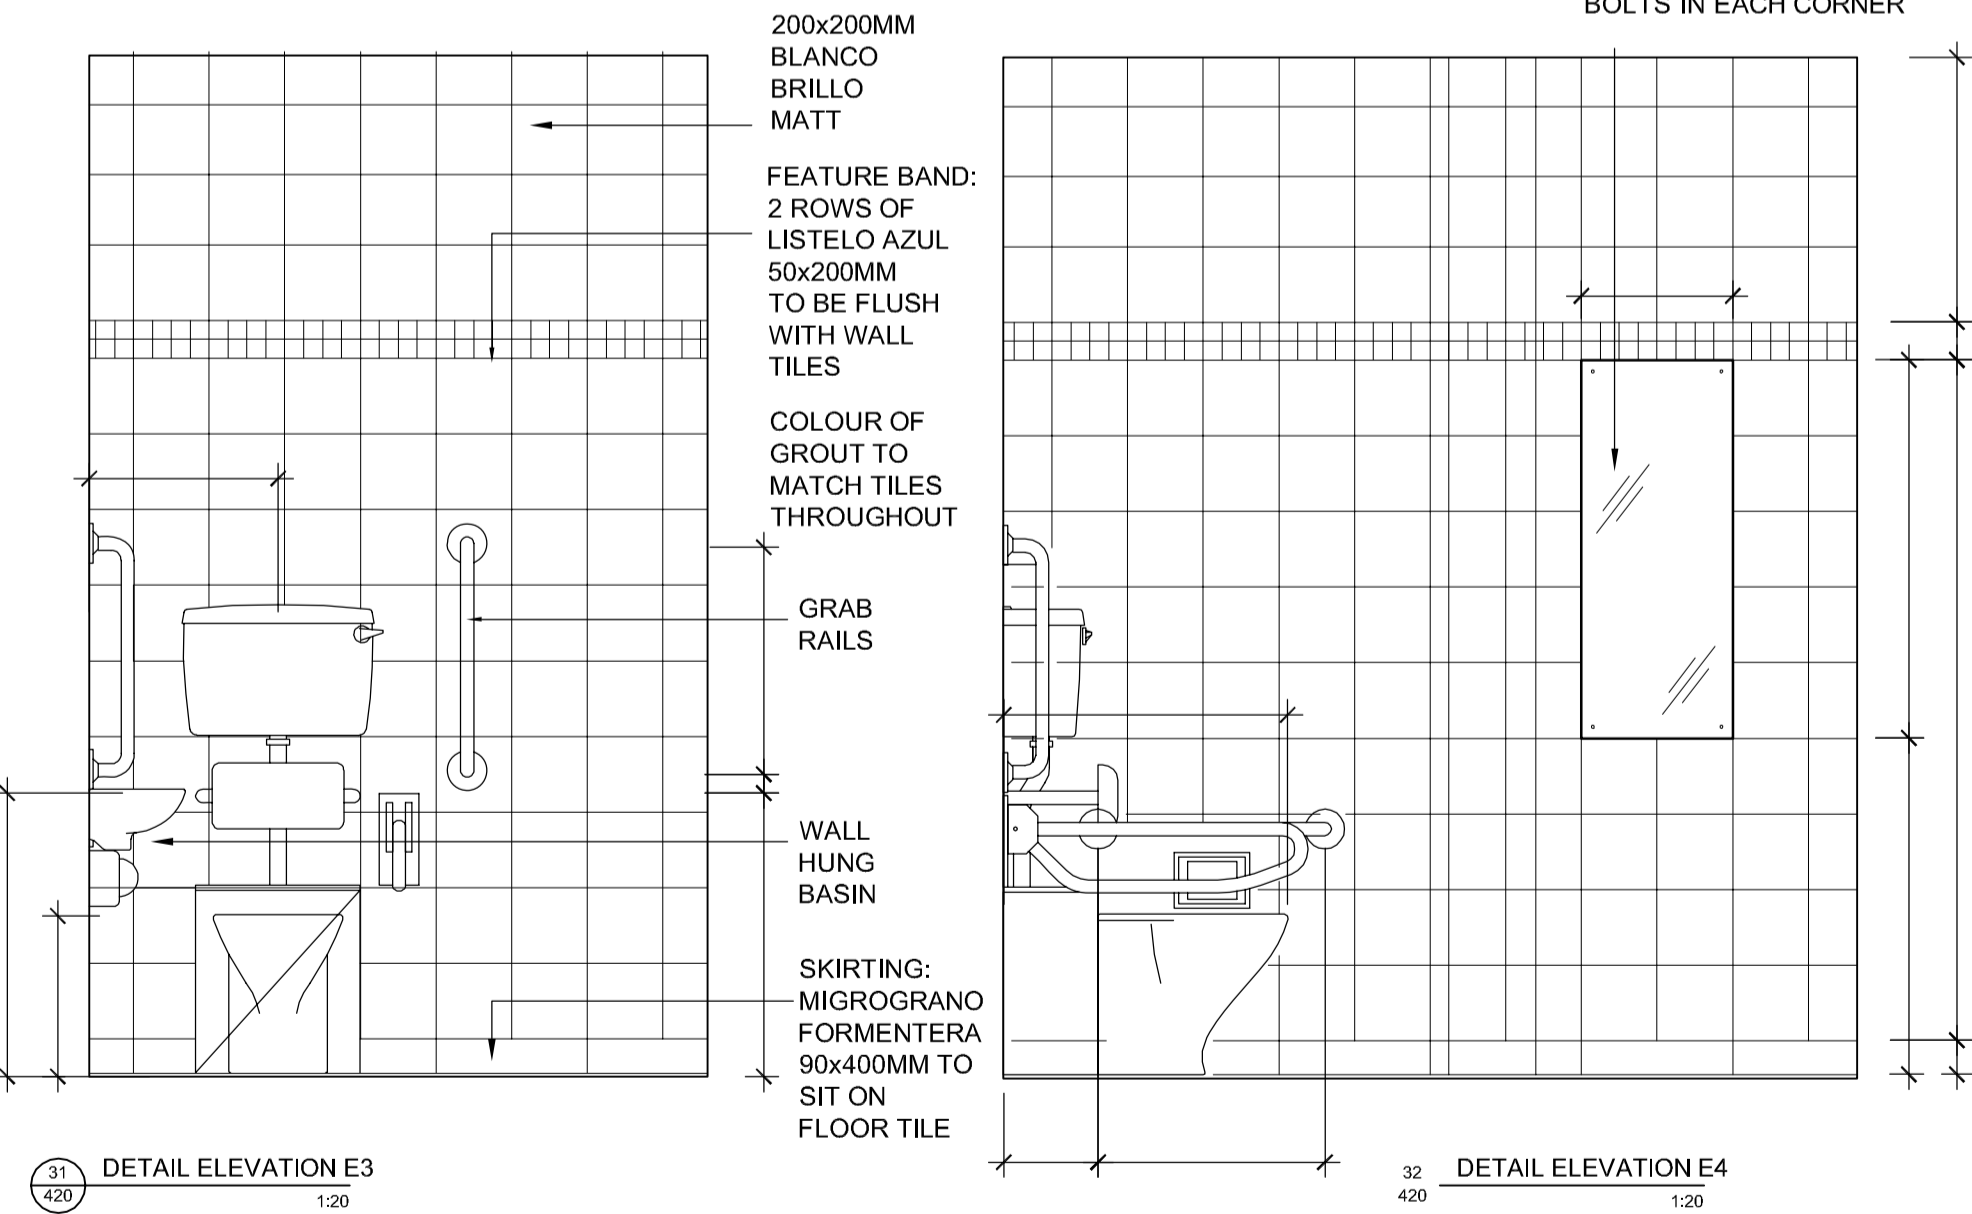
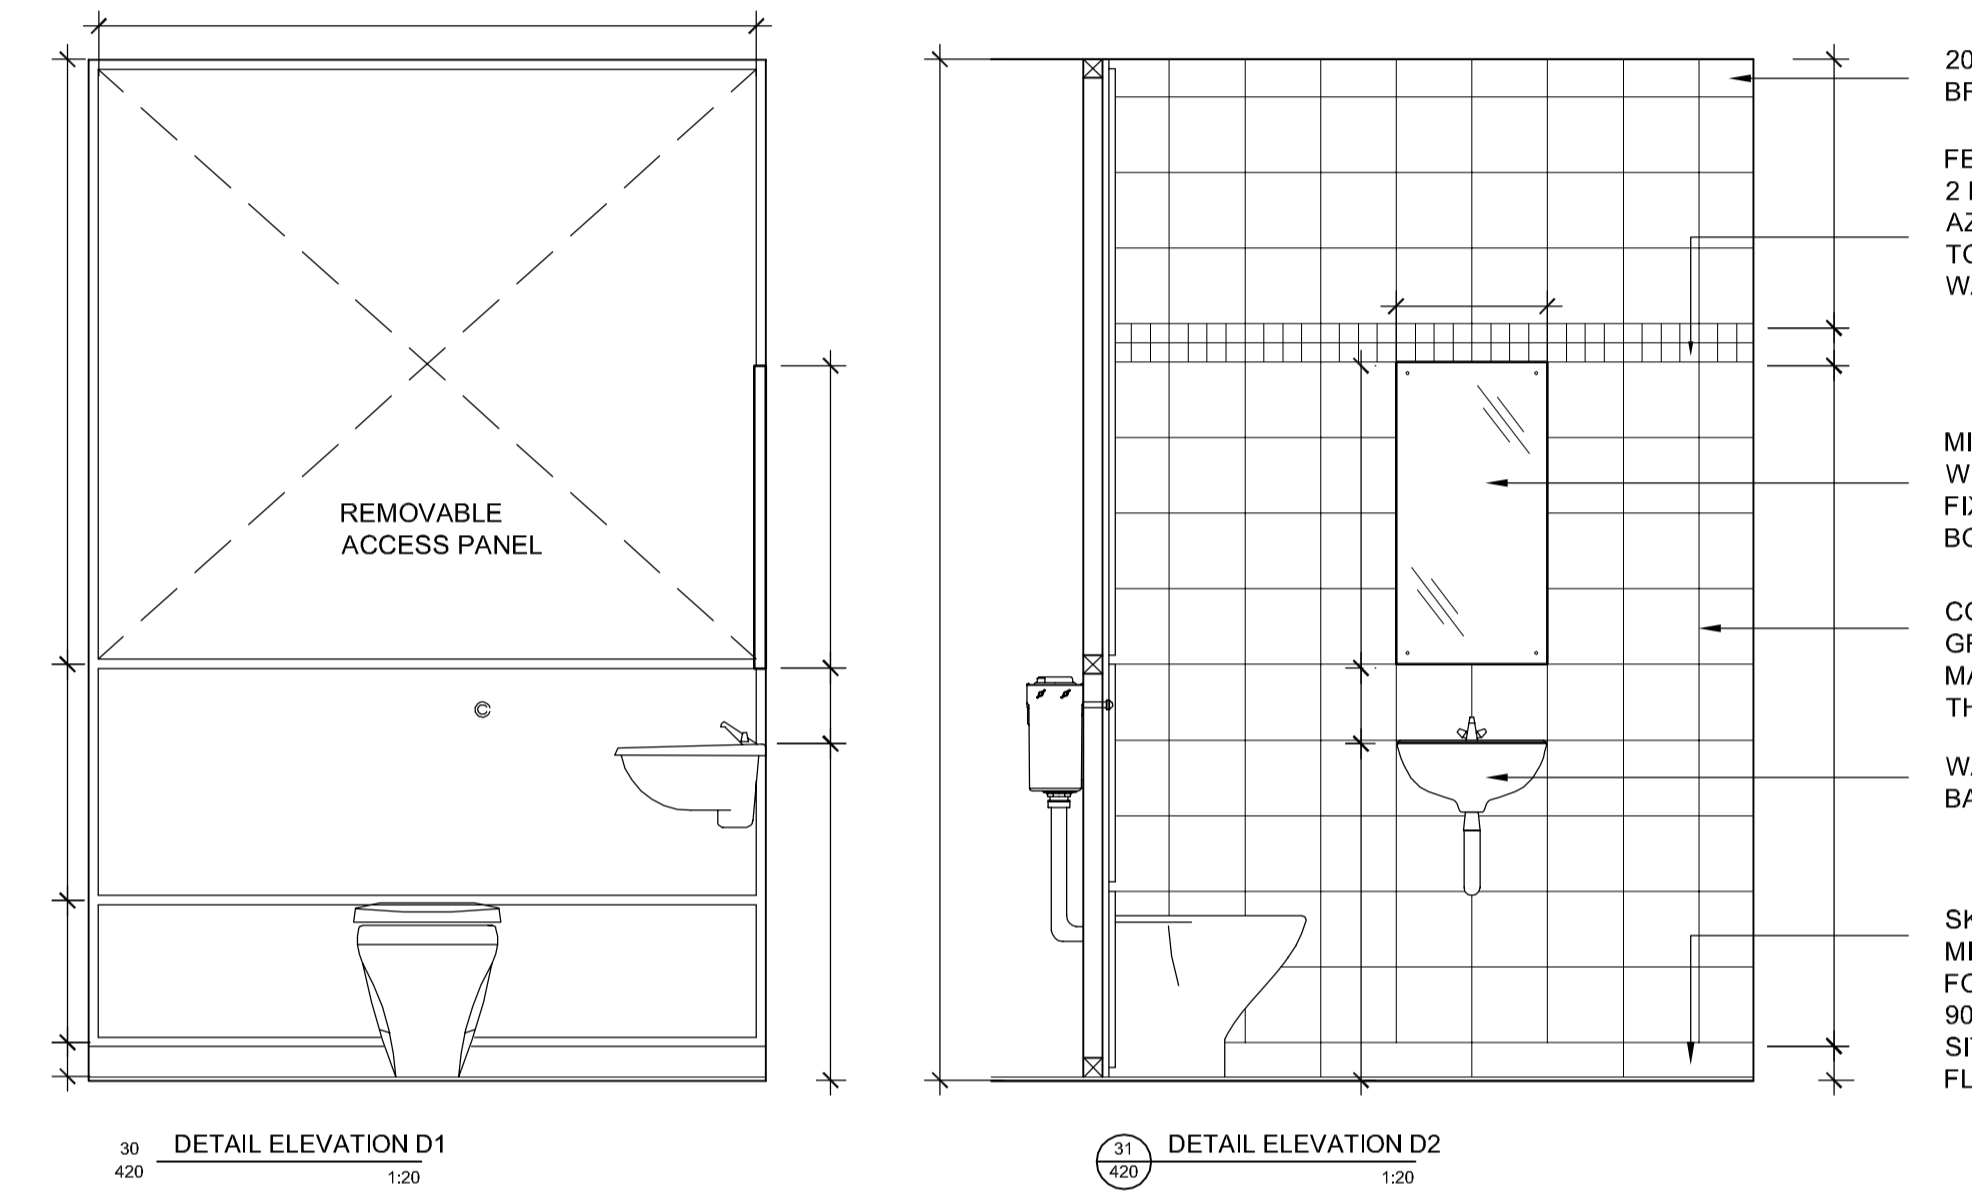
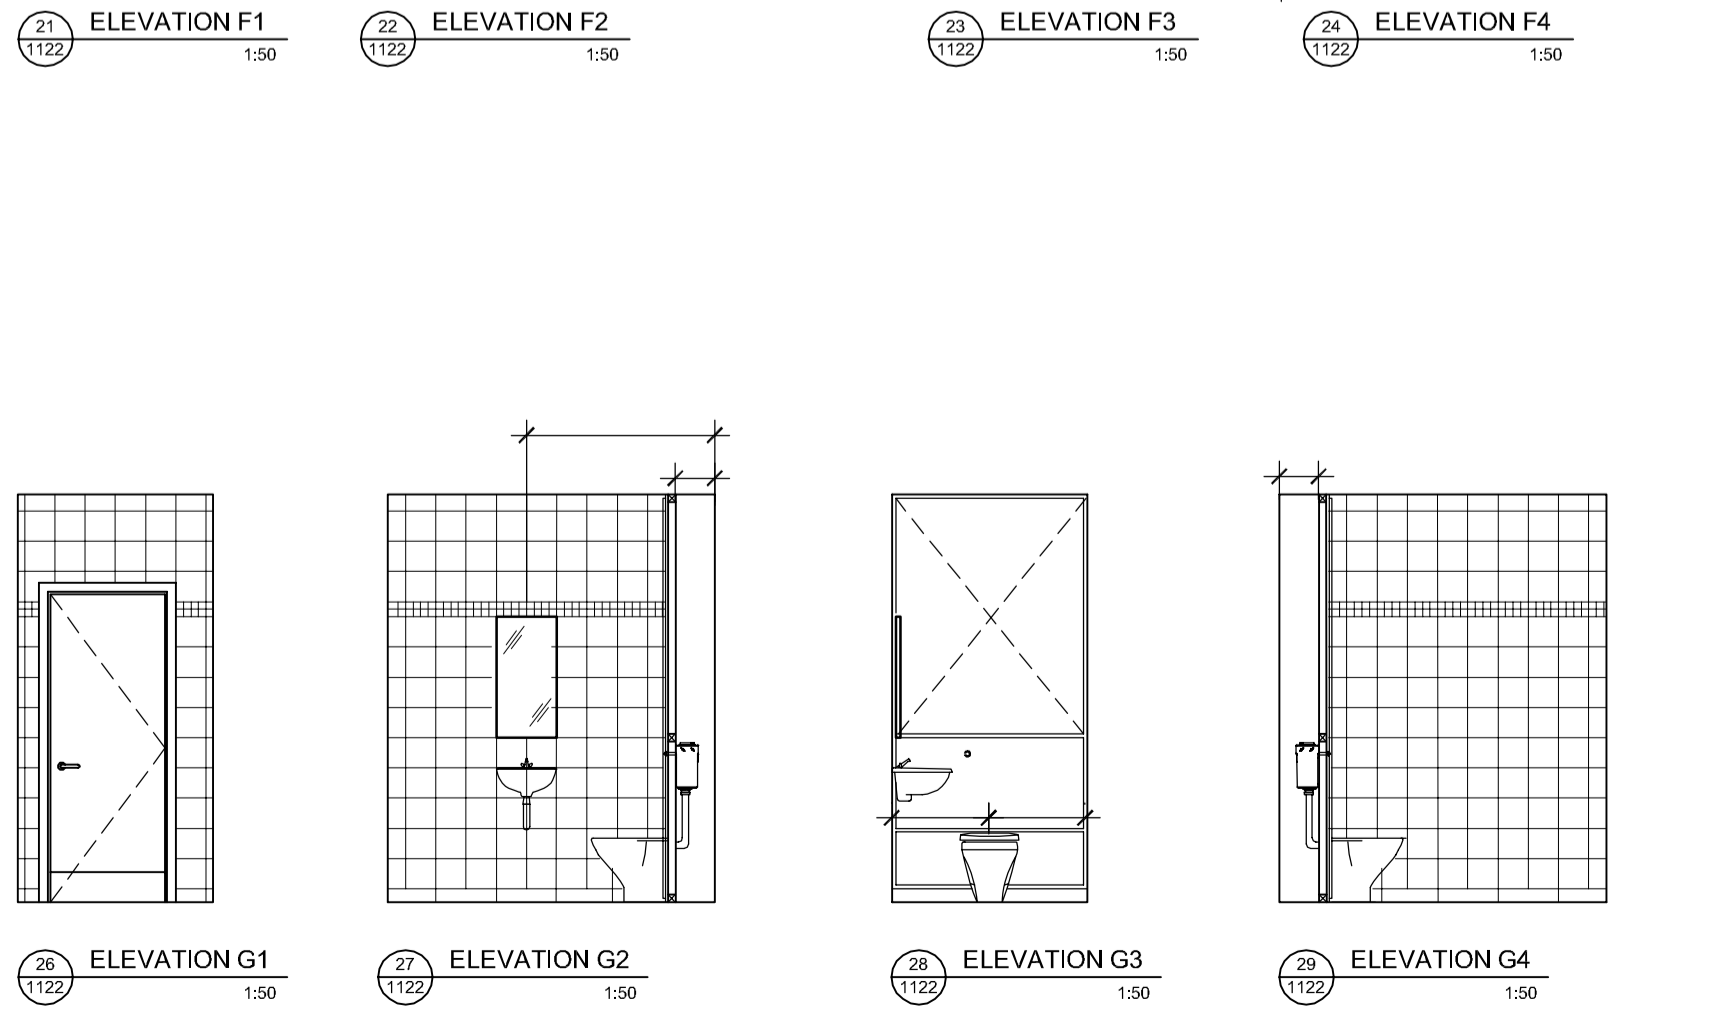
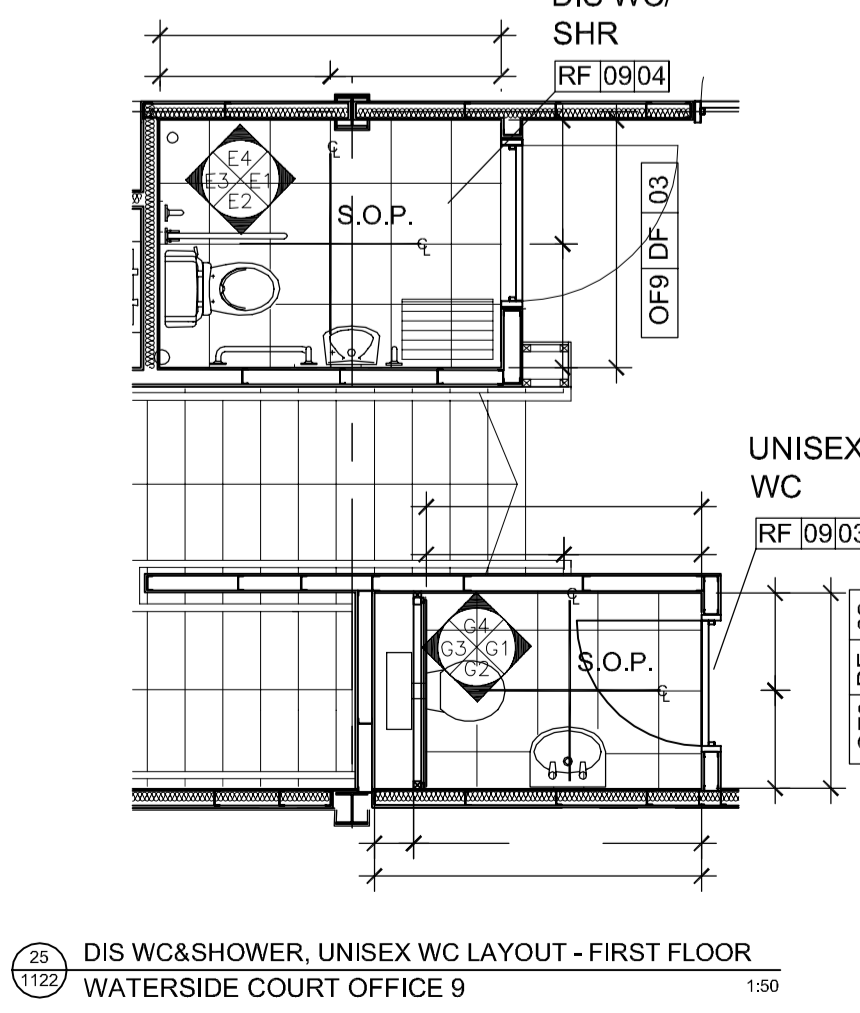
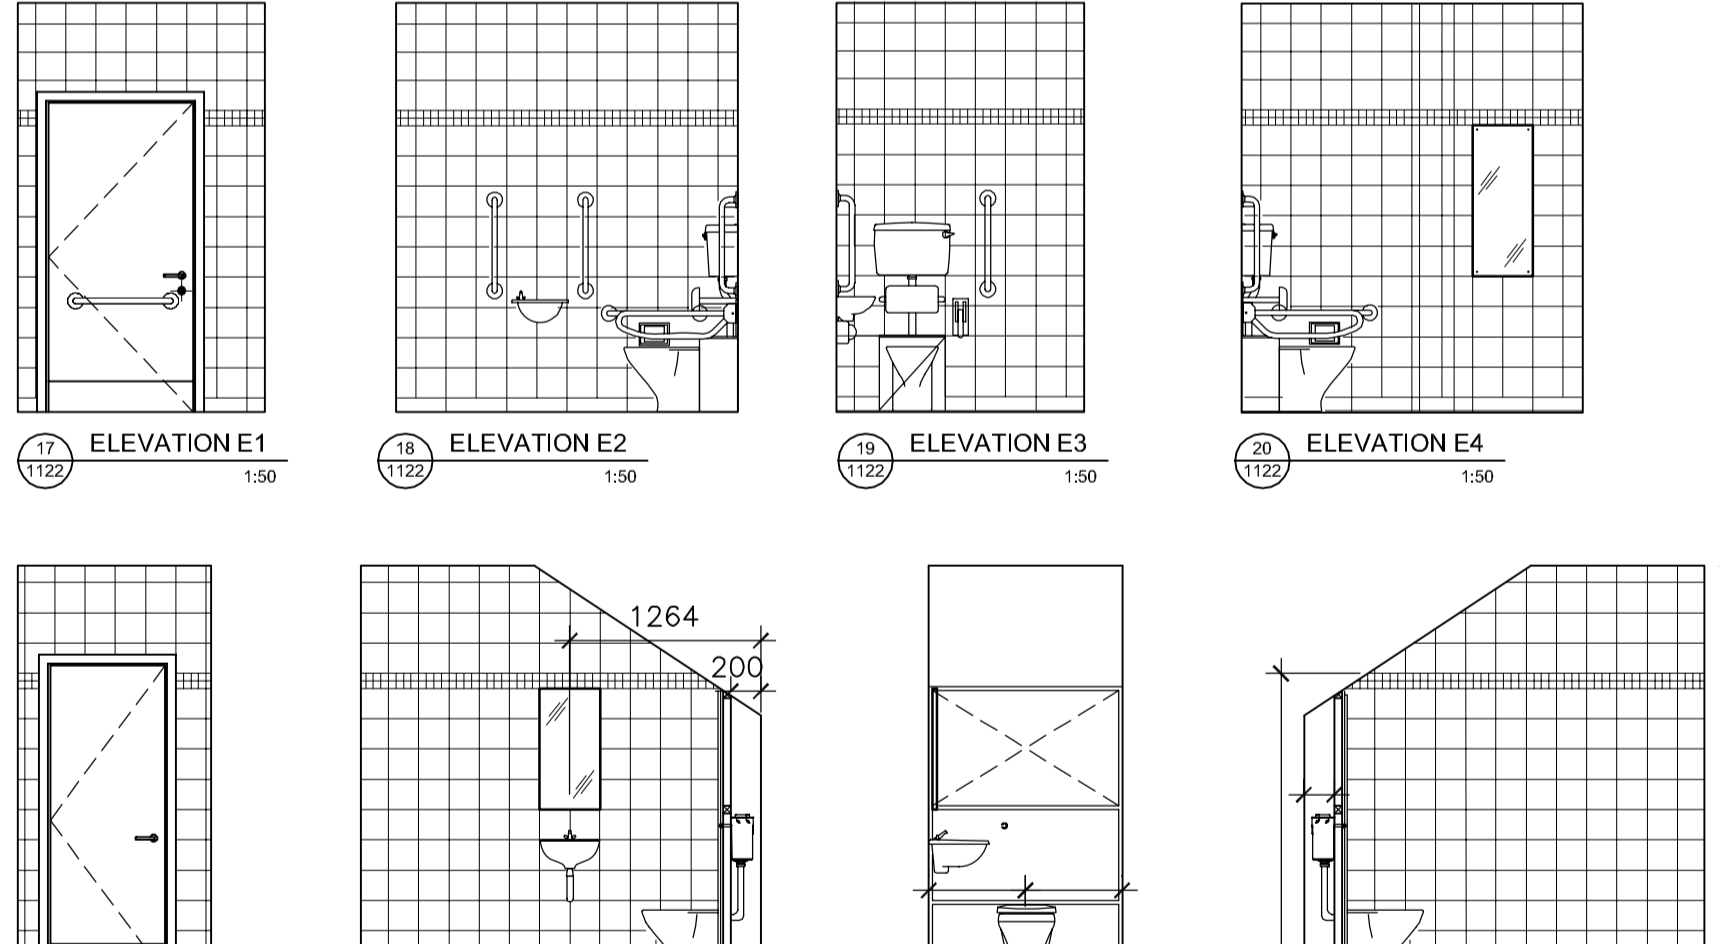
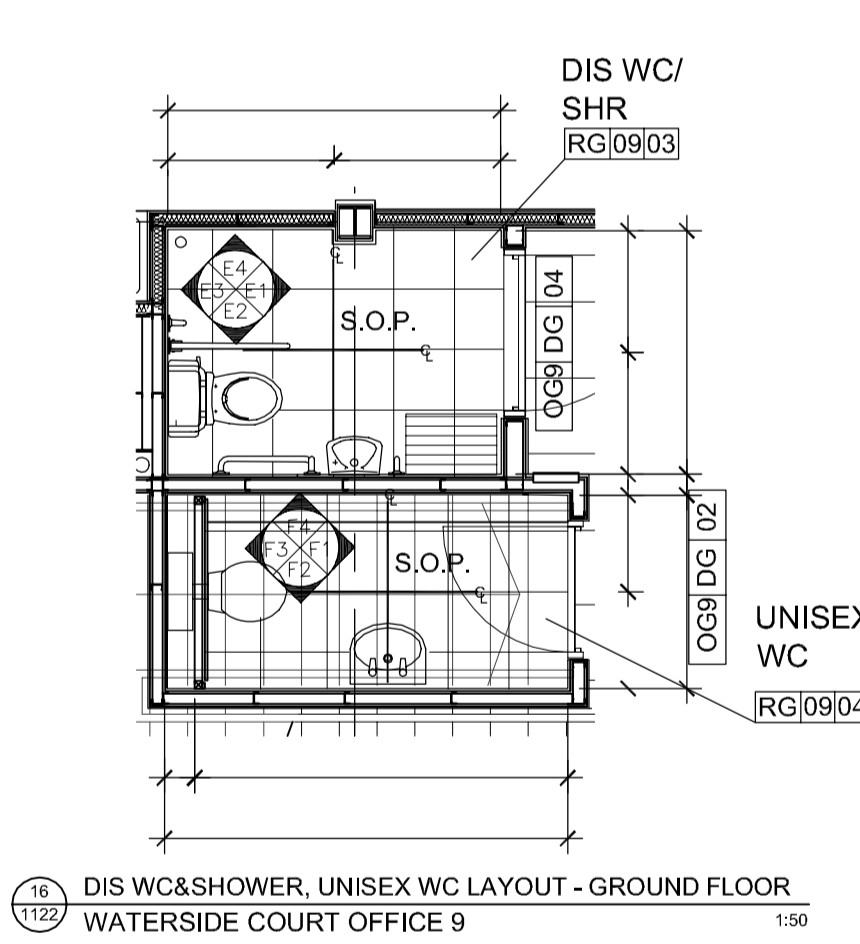
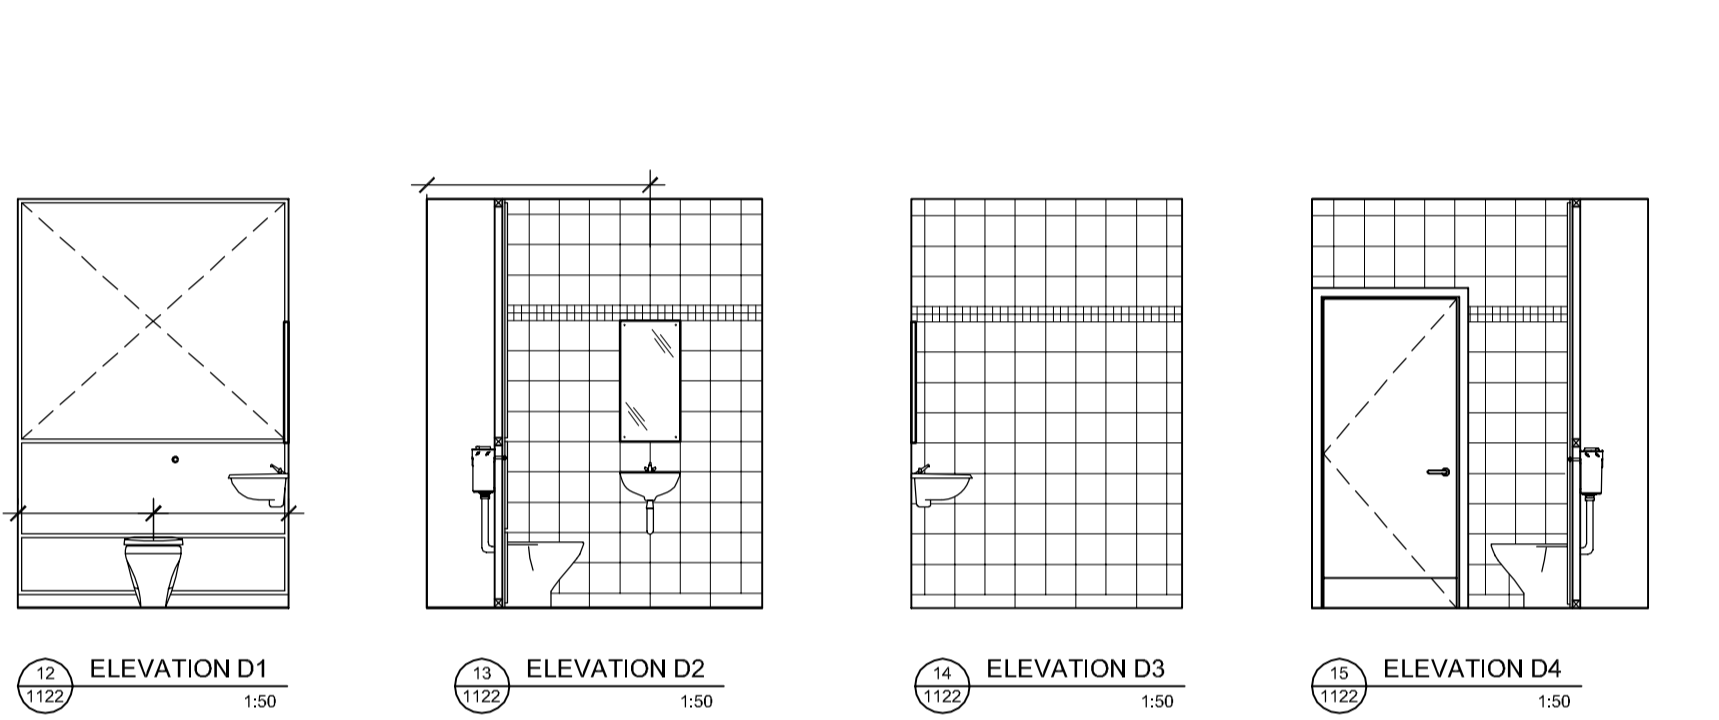
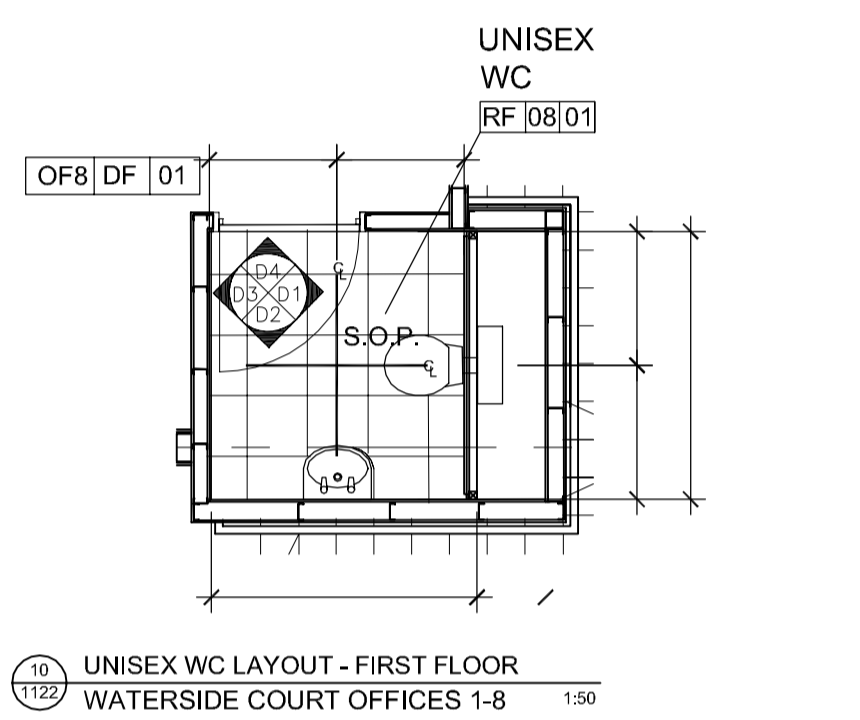
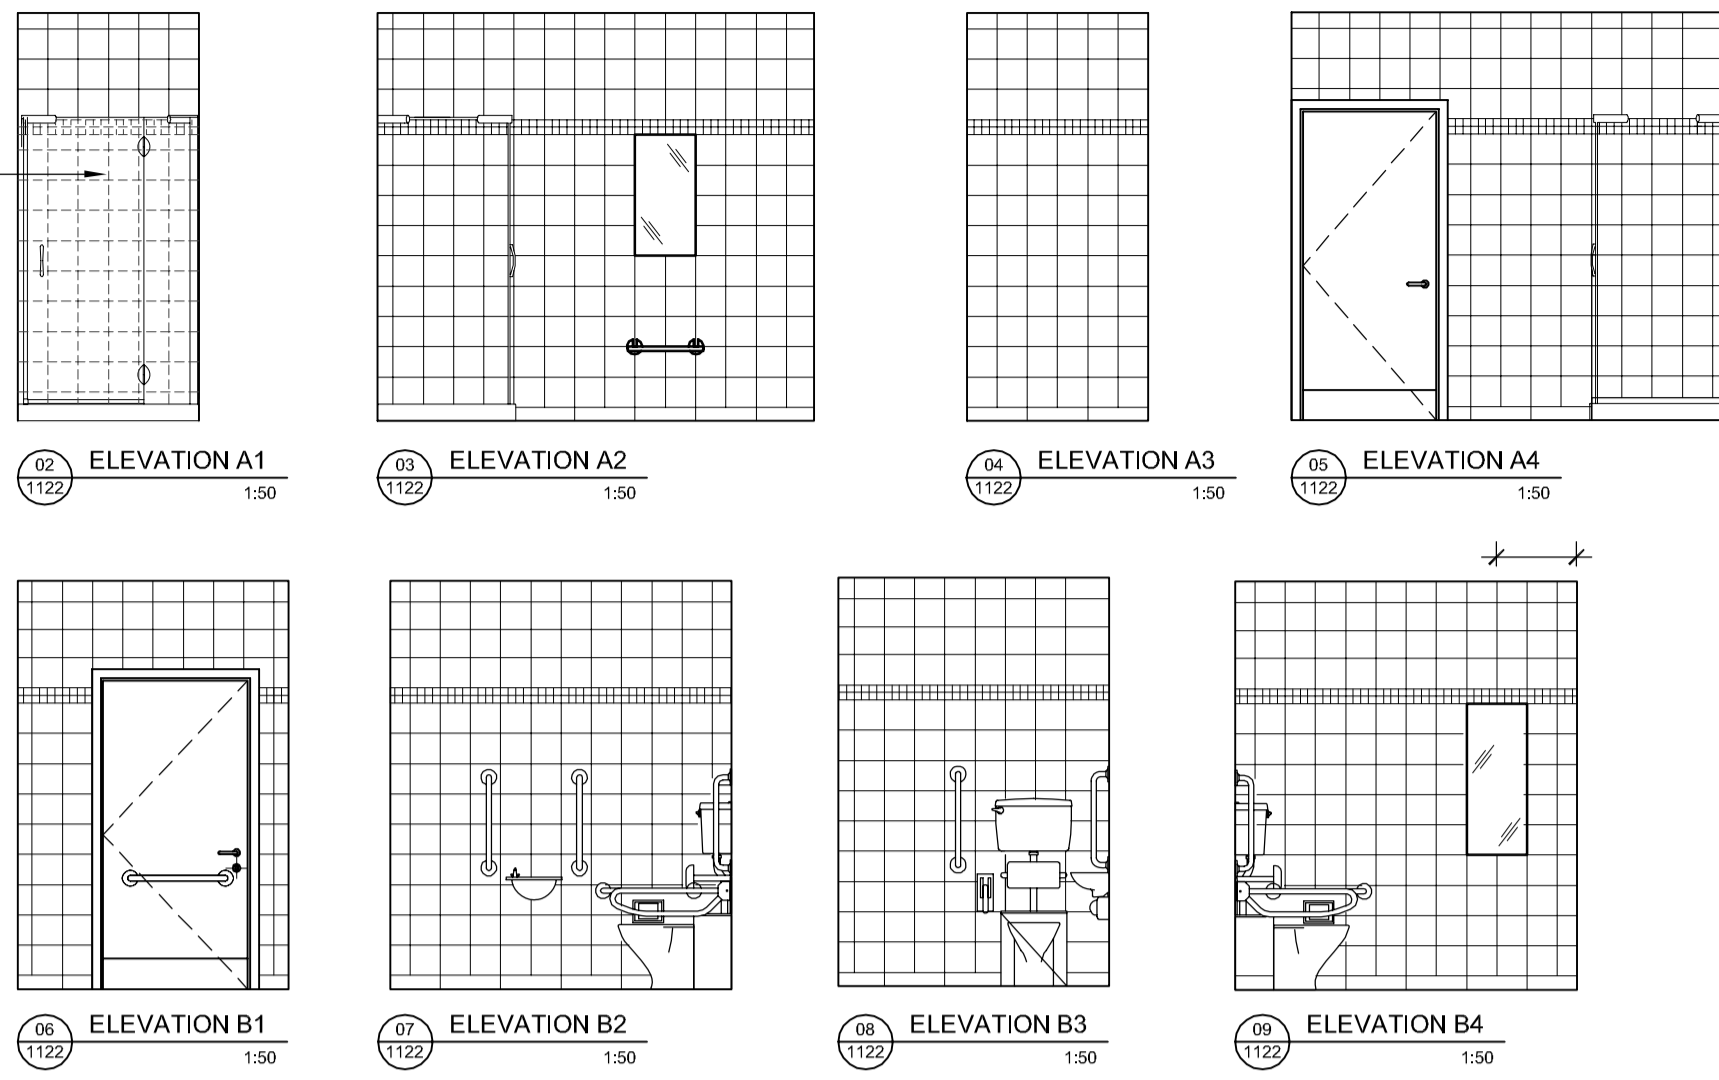


NOTES:

SUBJECT TO STATUTORY CONSENTS
 SUBJECT TO SURVEY
 COPYRIGHT RESERVED
 DO NOT SCALE THIS DRAWING
 DO NOT USE ELECTRONIC VERSIONS OF THIS DRAWING
 TO DETERMINE DIMENSIONS UNLESS SPECIFICALLY
 AUTHORISED BY MICHAEL SPARKS ASSOCIATES
 IF USING AN ELECTRONIC VERSION OF THIS DRAWING
 FIGURED DIMENSIONS TAKE PRECEDENCE AND NOTIFY
 MICHAEL SPARKS ASSOCIATES OF ANY
 DISCREPANCIES
 BASED ON OS MAP REPRODUCED BY PERMISSION OF
 CONTROLLER OF HM STATIONARY OFFICE (c) CROWN
 COPYRIGHT

NOTE:
 DISABLED TOILET FITTINGS TO COMPLY
 WITH PART M OF THE BUILDING
 REGULATIONS.
 ALL INTERNAL MATERIALS REFER TO
 FINISHES SCHEDULE 2716/SD/400-2
 THIS DRAWING TO BE READ IN
 CONJUNCTION WITH SANITARYWARE
 SCHEDULE 2716/SD/441
 SETTING OUT OF TILES
 CENTERED WITH CUT TILES EITHER SIDE

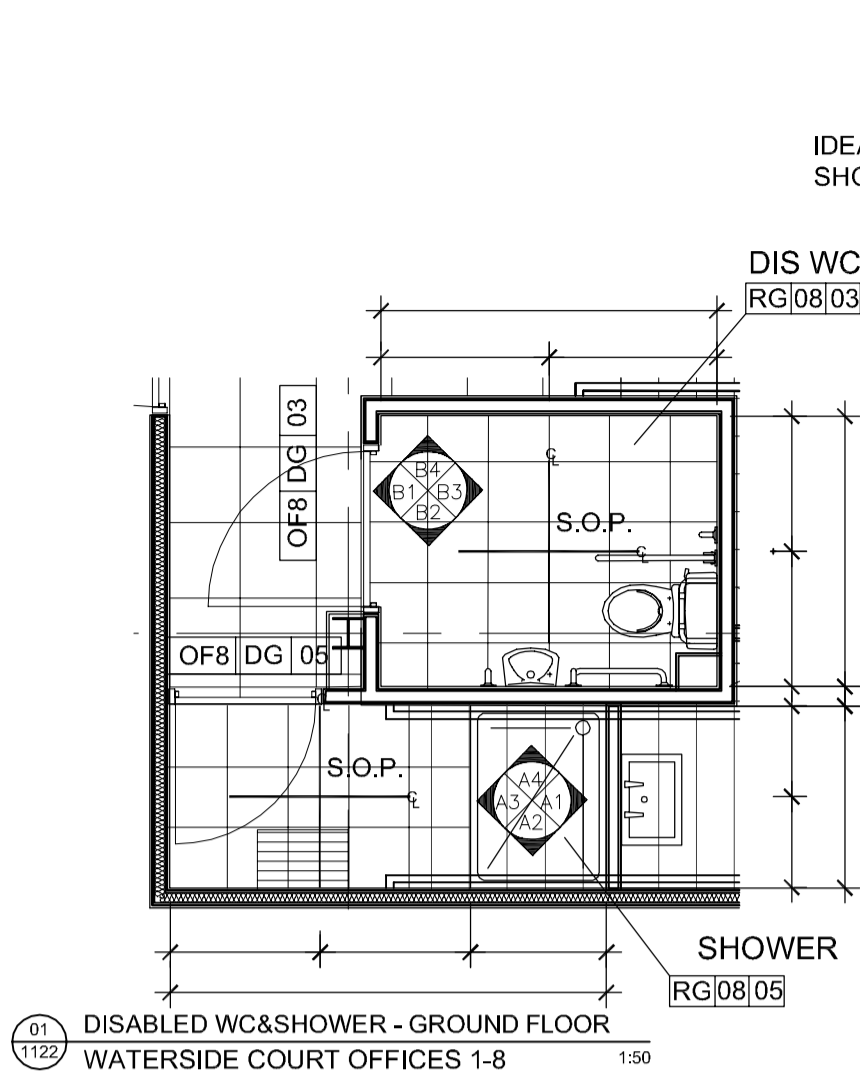

200x200MM BLANCO BRILLO MATT
 FEATURE BAND:
 2 ROWS OF LISTELO AZUL 50x200MM TO BE FLUSH WITH WALL TILES
 MIRRORS TO BE FLUSH WITH WALL TILES AND FIXED WITH PIGNOSE BOLTS IN EACH CORNER
 COLOUR OF GROUT TO MATCH TILES THROUGHOUT
 WALL HUNG BASIN
 SKIRTING: MIGROGRANO FORMENTERA 90x400MM TO SIT ON FLOOR TILE

AS BUILT			
THIS "AS-BUILT" DRAWING IS BASED ON INFORMATION SUPPLIED TO MICHAEL SPARKS ASSOCIATES BY MC LAREN CONSTRUCTION AND INCORPORATES INSTRUCTIONS AND OTHER DESIGN INFORMATION GIVEN TO MC LAREN CONSTRUCTION DIRECTLY BY OTHERS			
A	25.03.2009	Refer to sub-contractors drawings for specialist details This supercedes drawing no: 2716/EL/420 rev.B	JH NSC
REV	DATE	COMMENT	DRAWN CHECK

MICHAEL SPARKS ASSOCIATES
 CHARTERED ARCHITECTS
 11 PLATO PLACE
 ST DIONIS ROAD
 LONDON SW6 4TU
 TELEPHONE 020 7736 6162
 FAX 020 7736 3896
 info@msa-architects.co.uk

FROGMORE

TITLE CROSSWAYS, DARTFORD		
DRAWING INTERIOR WC DETAILS WATERSIDE COURT OFFICES		
CLIENT FROGMORE		
DATE MARCH 2009	SCALE 1:20, 1:50 @ A1	DRAWN JH
STATUS AS BUILT		CHECKED NSC
DRAWING NUMBER 2716 / AB / 1122 A		