

**NOTES:**  
 SUBJECT TO STATUTORY CONSENTS  
 SUBJECT TO SURVEY  
 BASED ON OS MAP REPRODUCED BY PERMISSION OF CONTROLLER OF HM STATIONARY OFFICE (c) CROWN COPYRIGHT  
 COPYRIGHT RESERVED  
 DO NOT SCALE THIS DRAWING  
 DO NOT USE ELECTRONIC VERSIONS OF THIS DRAWING TO DETERMINE DIMENSIONS UNLESS SPECIFICALLY AUTHORISED BY MICHAEL SPARKS ASSOCIATES  
 IF USING AN ELECTRONIC VERSION OF THIS DRAWING FIGURED DIMENSIONS TAKE PRECEDENCE AND NOTIFY MICHAEL SPARKS ASSOCIATES OF ANY DISCREPANCIES


ENSURE SEALING OF ALL JUNCTIONS TO COMPLY WITH PART L.

NOTE:  
 CONTRACTOR:  
 CLADDING DETAILS TO BE READ IN CONJUNCTION WITH THE SPECIFICATION AND ALL RELEVANT BRITISH STANDARDS. INCLUDE VAPOUR BARRIER TAPE AROUND ALL OPENINGS AND JUNCTIONS.

ALL DIMENSIONS TO BE CHECKED ON SITE.  
 STEEL COLUMN SIZES TO BE CONFIRMED AND TOLERANCES TO BE AGREED.

- A 6mm CLEAR LOW E-GLASS TOUGHENED  
16mm ARGON SPACER COMPRISING 90% ARGON  
6.4mm SOFT COAT LAMINATED
- B 6mm SATIN SANDBLASTED TOUGHENED  
16mm ARGON SPACER COMPRISING 90% ARGON  
6.4mm SOFT COAT LAMINATED
- 1 6.8mm VANCEVA LAMINATED BLUE GLASS TOUGHENED PANE - REF TRUE BLUE  
16mm ARGON SPACER COMPRISING 90% ARGON  
6mm CLEAR LOW E-GLASS TOUGHENED
- 2 6.8mm VANCEVA LAMINATED BLUE GLASS TOUGHENED PANE - REF AQUAMARINE  
16mm ARGON SPACER COMPRISING 90% ARGON  
6mm CLEAR LOW E-GLASS TOUGHENED
- 3 6.8mm VANCEVA LAMINATED BLUE GLASS TOUGHENED PANE - REF SAPPHIRE  
16mm ARGON SPACER COMPRISING 90% ARGON  
6mm CLEAR LOW E-GLASS TOUGHENED
- 4 6.8mm VANCEVA LAMINATED BLUE GLASS TOUGHENED PANE - REF 6166  
16mm ARGON SPACER COMPRISING 90% ARGON  
6mm CLEAR LOW E-GLASS TOUGHENED

01 1109 WATERSIDE COURT OFFICE 4-8 NORTH ELEVATION 1:100

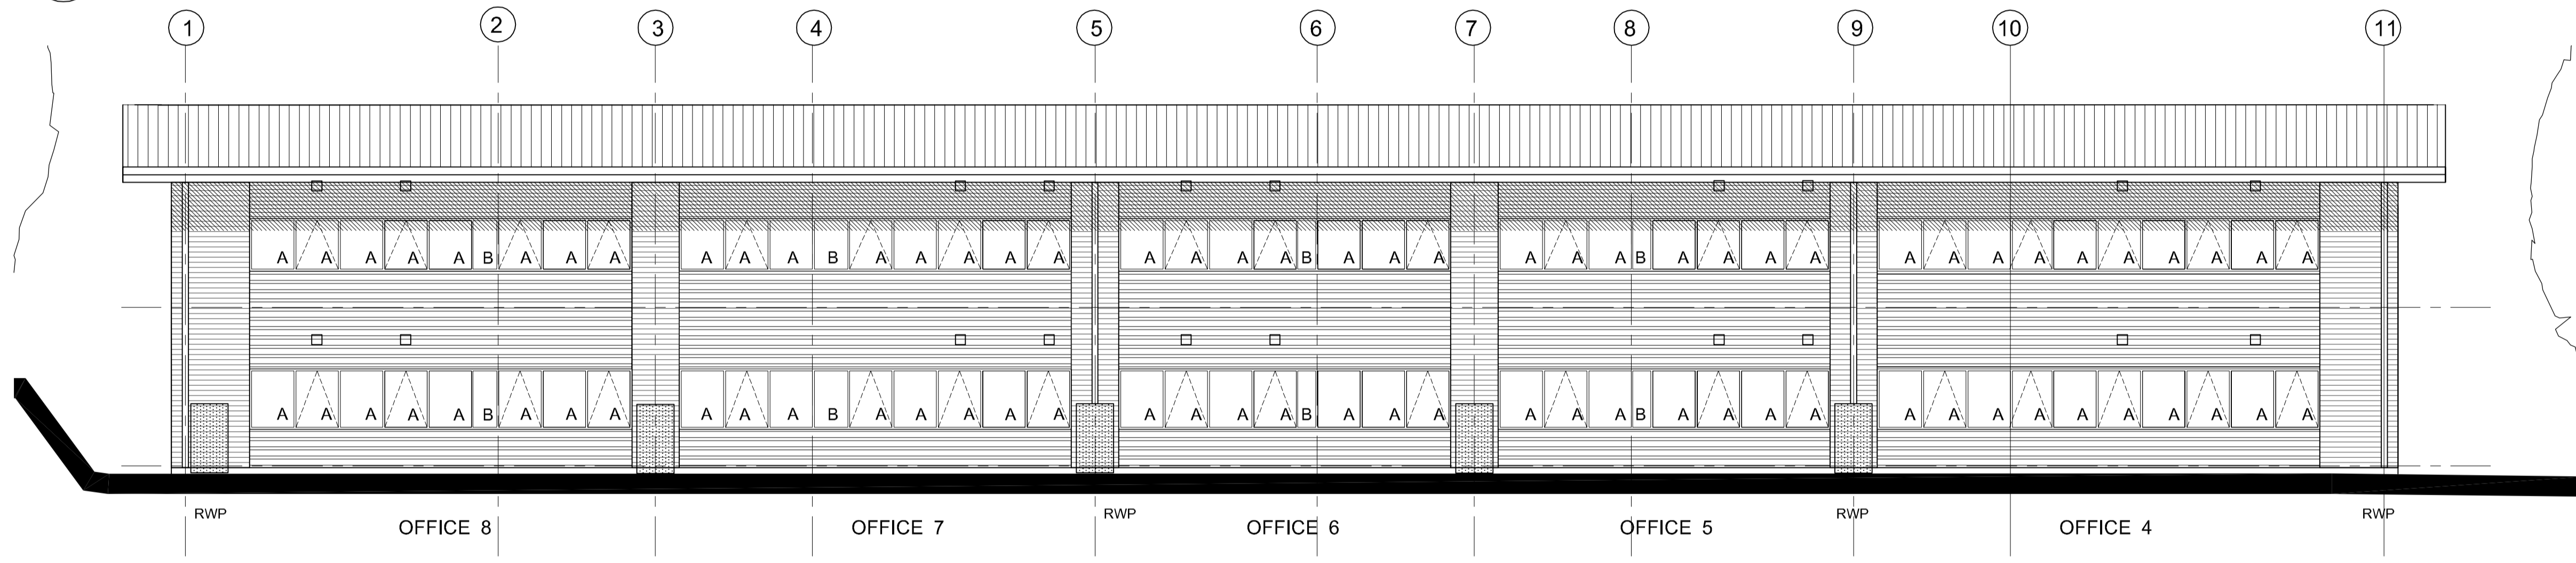


02 1109 WATERSIDE COURT OFFICE 4-8 SOUTH ELEVATION 1:100


# AS BUILT

THIS "AS-BUILT" DRAWING IS BASED ON INFORMATION SUPPLIED TO MICHAEL SPARKS ASSOCIATES BY MC LAREN CONSTRUCTION AND INCORPORATES INSTRUCTIONS AND OTHER DESIGN INFORMATION GIVEN TO MC LAREN CONSTRUCTION DIRECTLY BY OTHERS


A	25.03.2009	Refer to sub-contractors drawings for specialist details This supersedes drawing no: 2716/RE/308	JH	NSC
REV	DATE	NOTE	DRAW	CHK

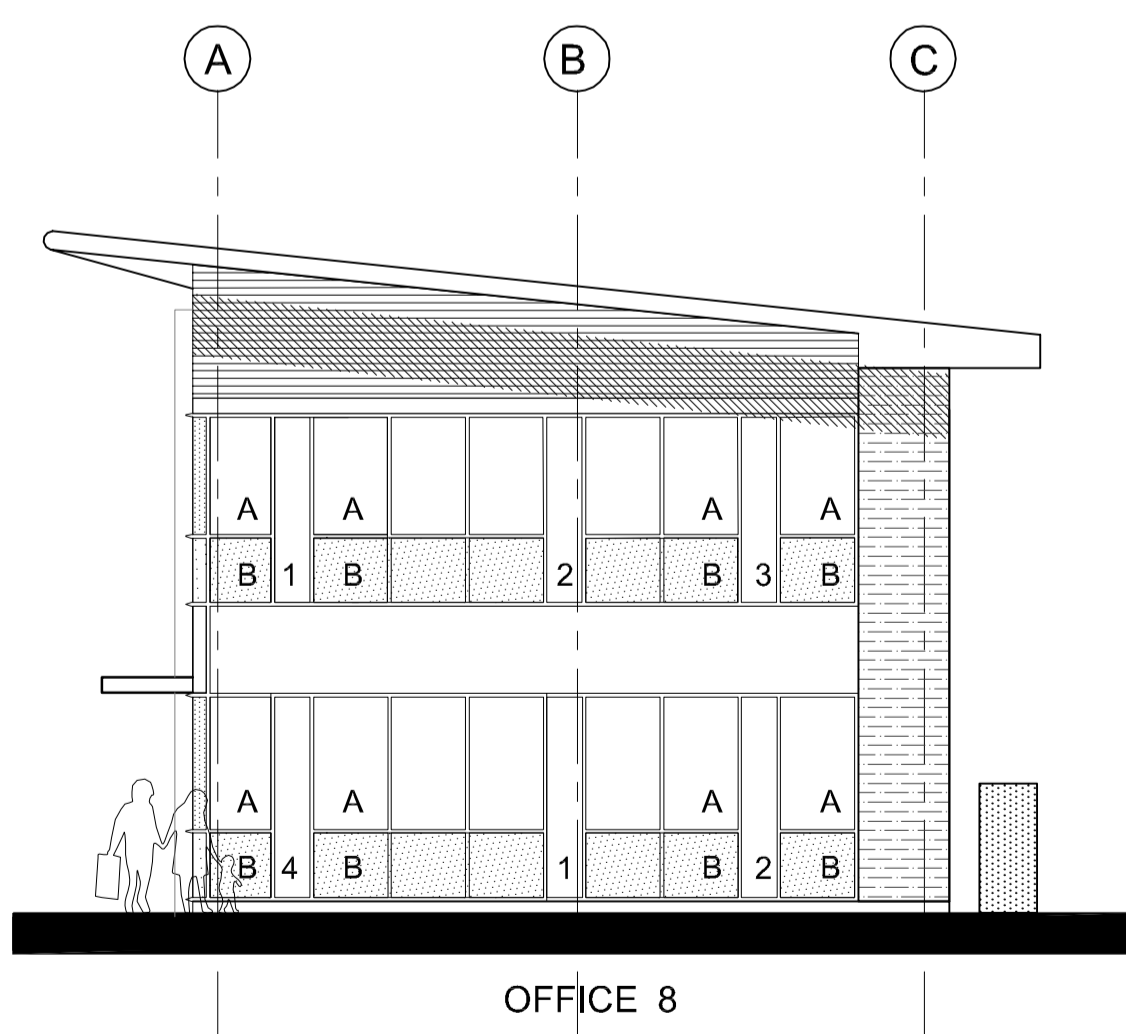

03 1109 WATERSIDE COURT OFFICE 4-8 WEST ELEVATION 1:100

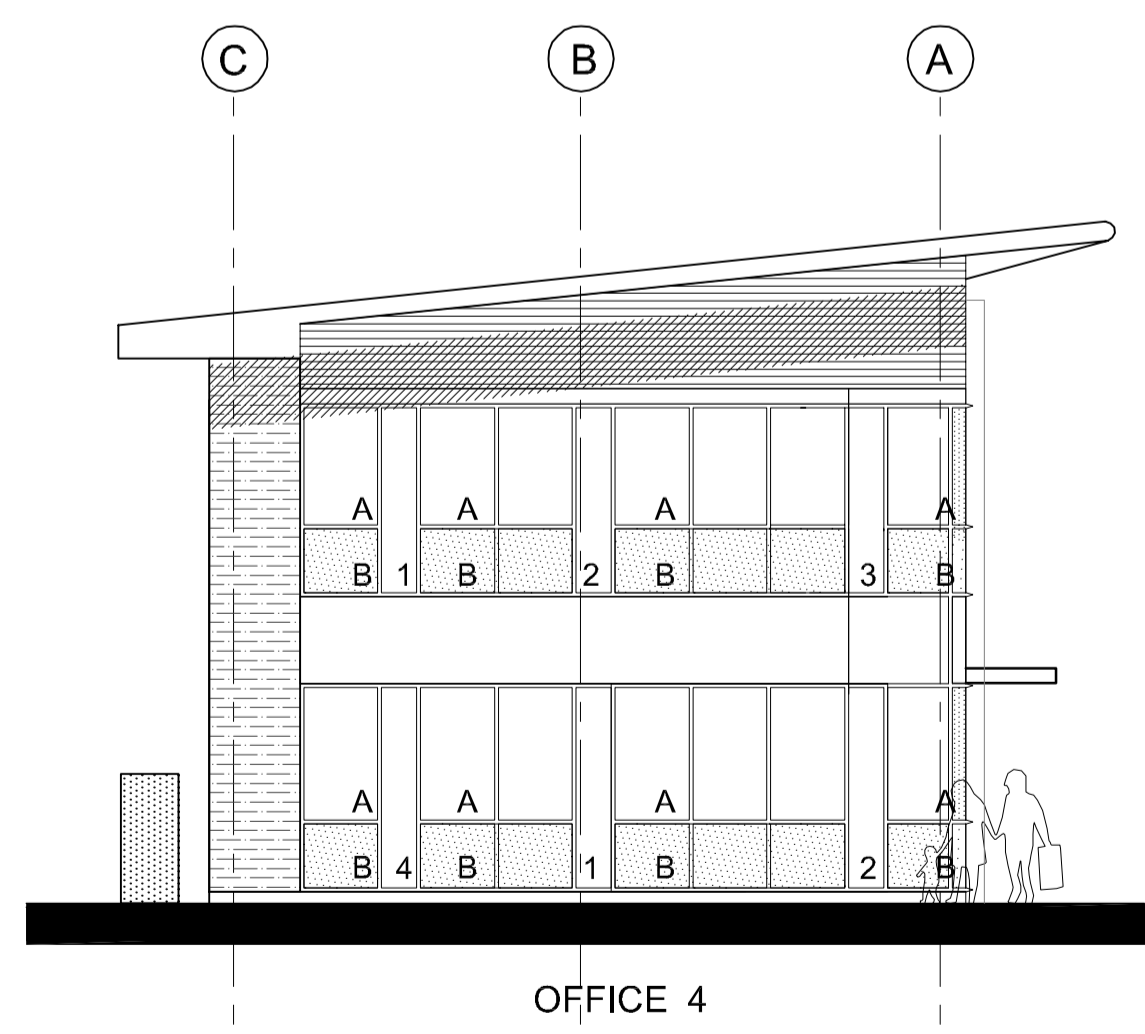

04 1109 WATERSIDE COURT OFFICE 4-8 EAST ELEVATION 1:100

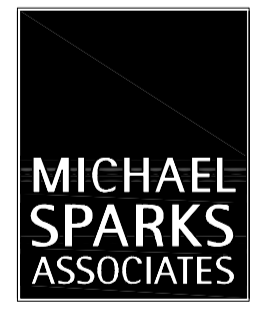

**FROGMORE**

CHARTERED ARCHITECTS  
 11 PLATO PLACE  
 ST. BONS ROAD  
 LONDON SW6 4TU  
 TELEPHONE 020 7736 6162  
 FAX 020 7736 3896  
 www.msa-architects.co.uk

TITLE  
**CROSSWAYS, DARTFORD**  
 DRAWING  
**WATERSIDE COURT OFFICE 4-8 ELEVATIONS**  
 CLIENT  
**FROGMORE**

DATE	SCALE	DRAWN
MARCH 2009	1:100 @ A1	JH
	STATUS	CHECKED
	AS BUILT	NSC

DRAWING NUMBER  
**2716 / AB/ 1109 A**