




01 WATERSIDE COURT OFFICE 9 EAST ELEVATION
1110 1:100

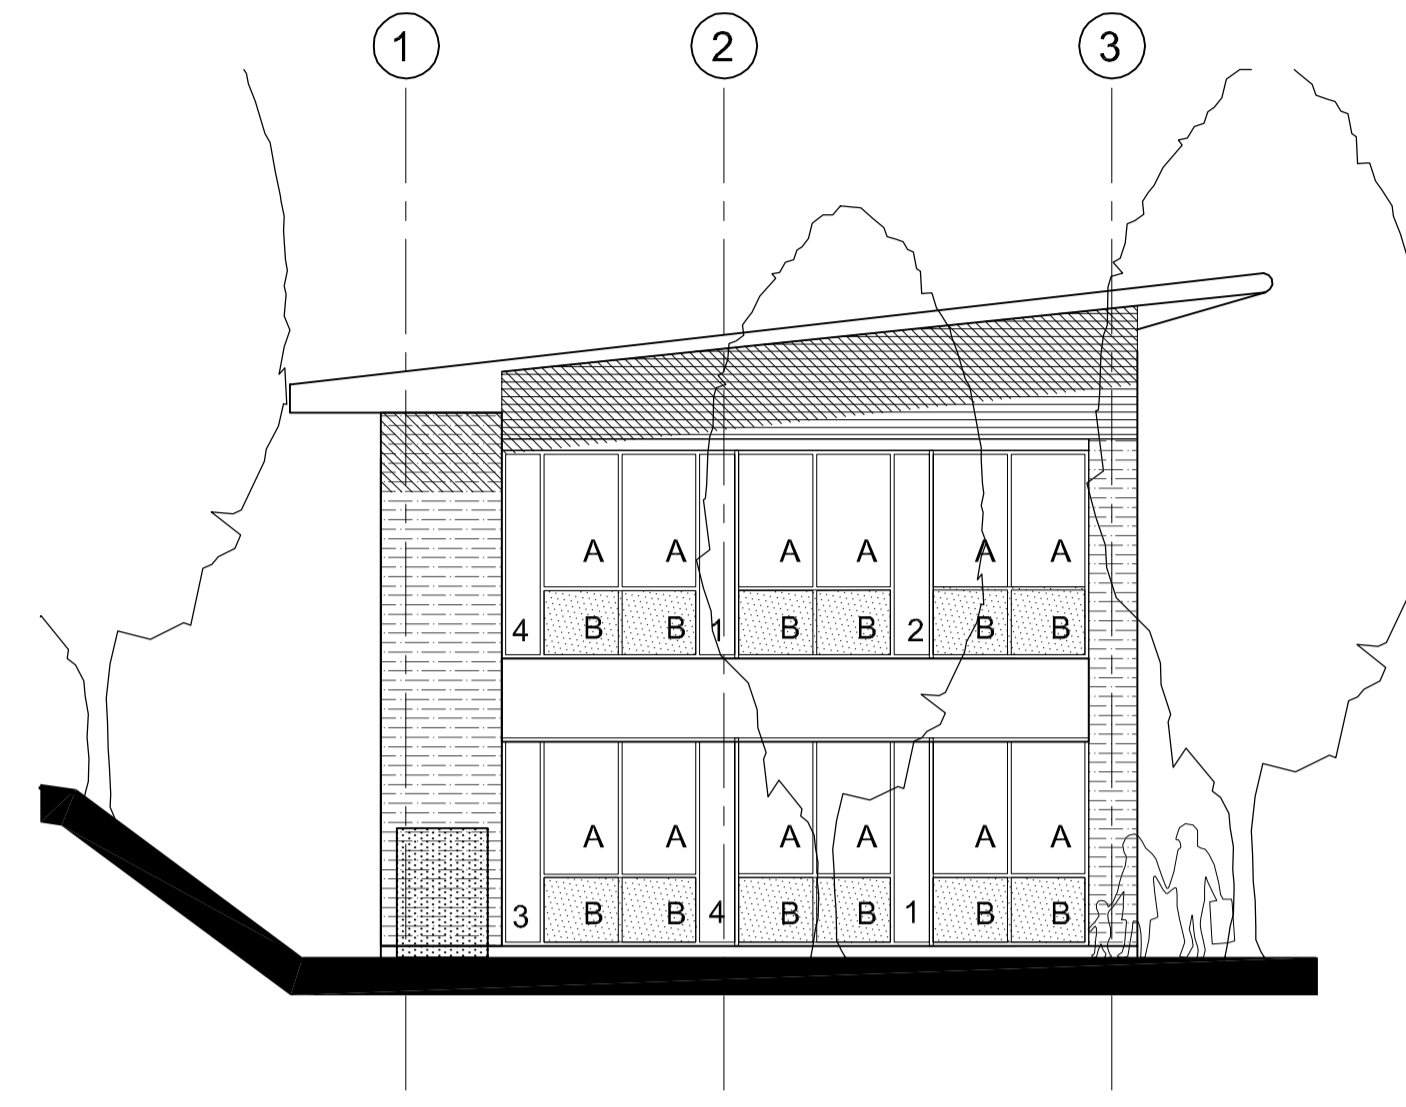

02 WATERSIDE COURT OFFICE 9 SOUTH ELEVATION
1110 1:100

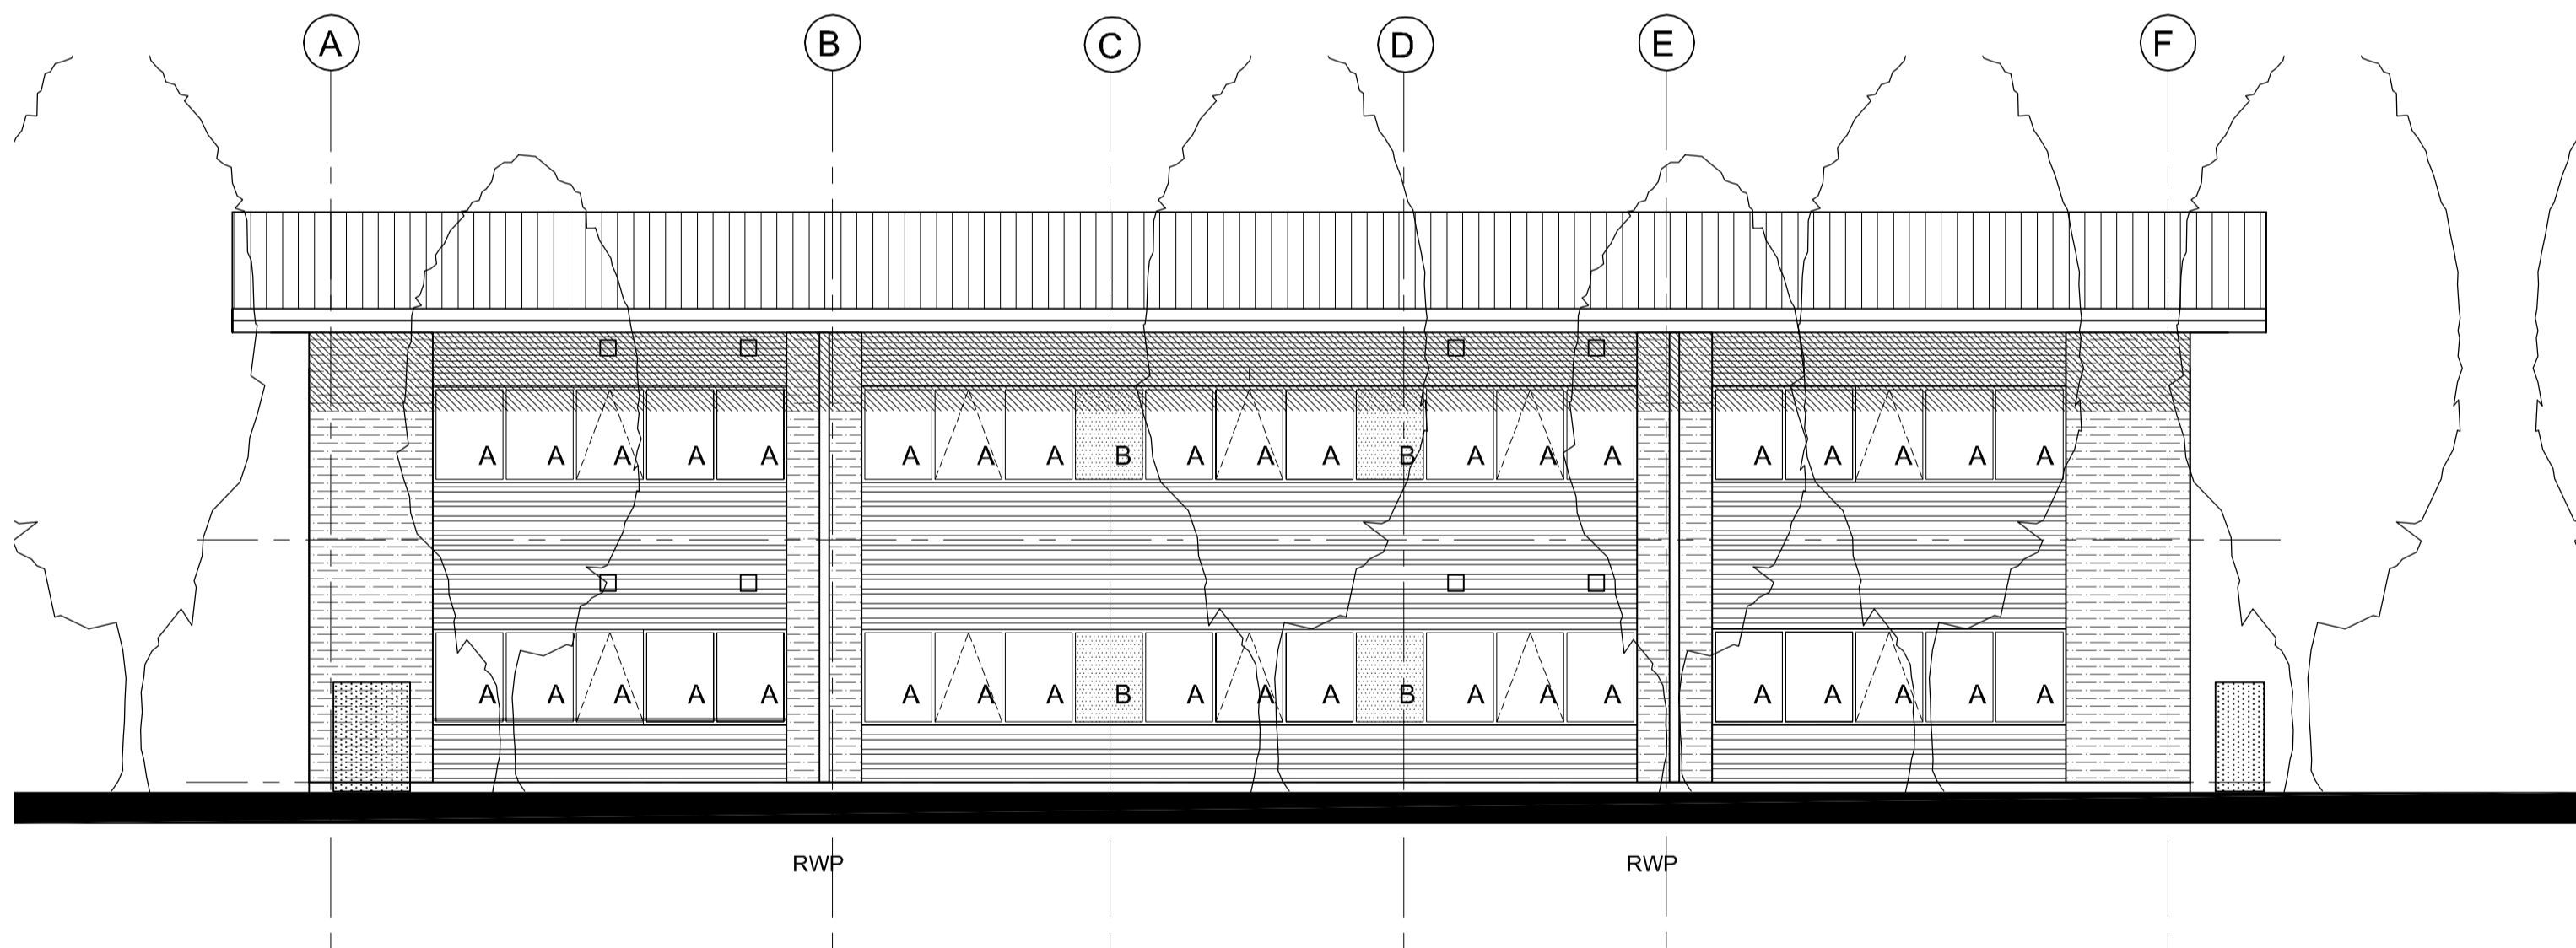

03 WATERSIDE COURT OFFICE 9 WEST ELEVATION
1110 1:100

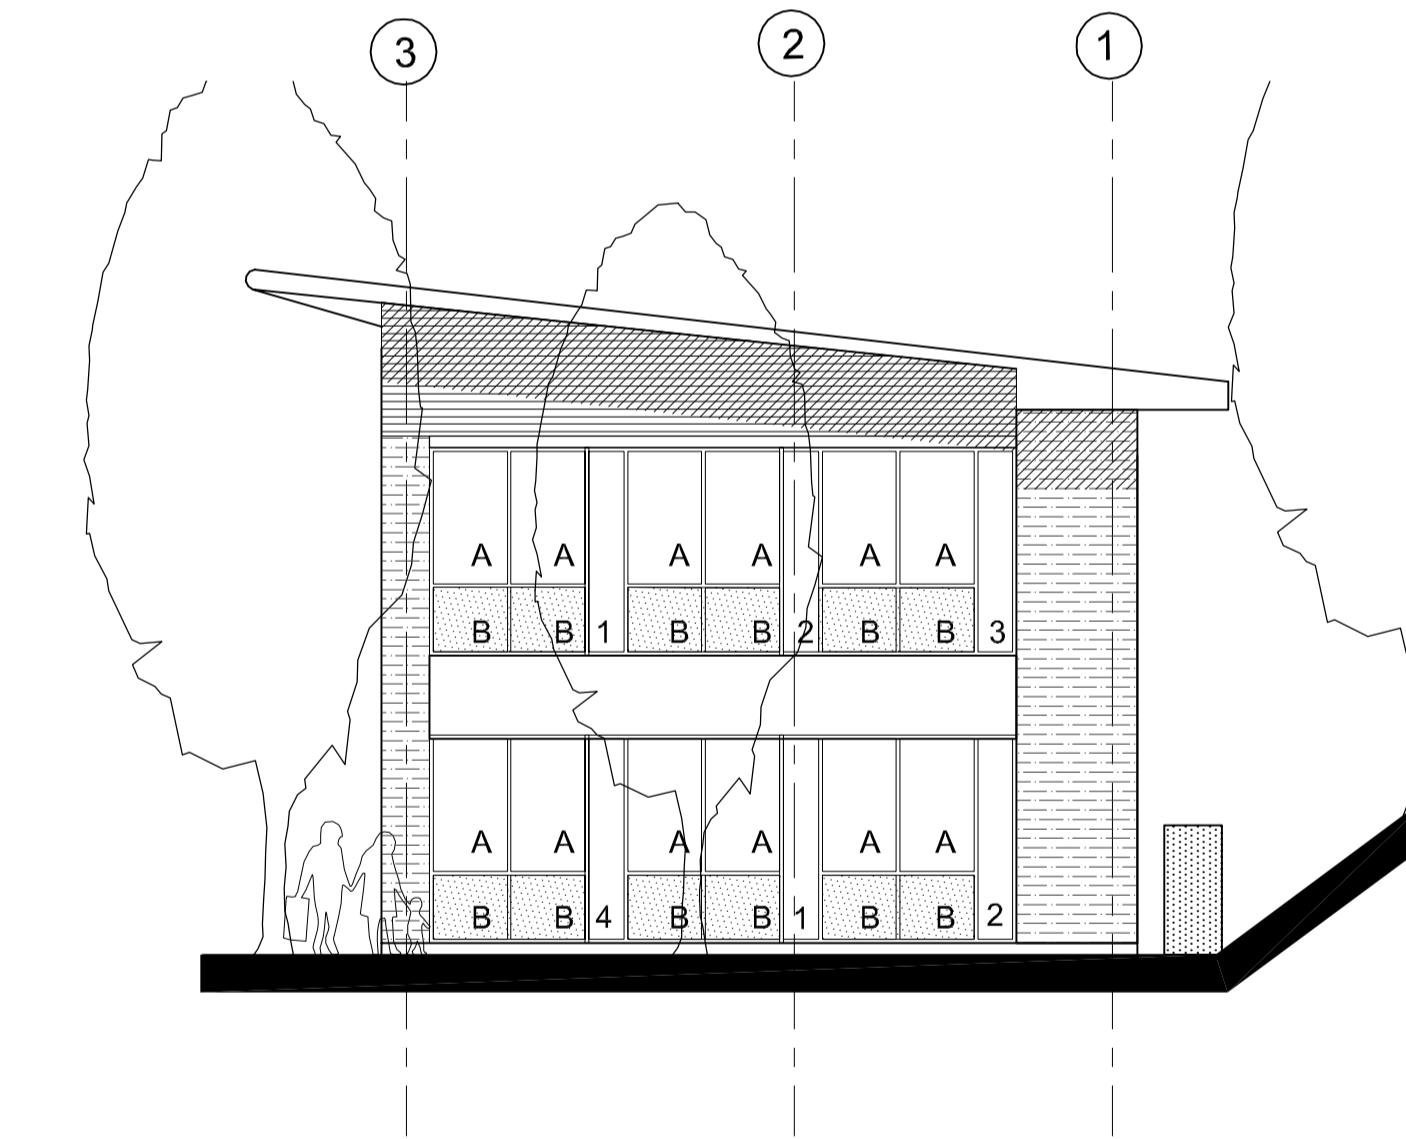

04 WATERSIDE COURT OFFICE 9 NORTH ELEVATION
1110 1:100

NOTES:

SUBJECT TO STATUTORY CONSENTS
 SUBJECT TO SURVEY
 BASED ON OS MAP REPRODUCED BY PERMISSION OF
 CONTROLLER OF HM STATIONARY OFFICE (c) CROWN
 COPYRIGHT
 COPYRIGHT RESERVED
 DO NOT SCALE THIS DRAWING
 DO NOT USE ELECTRONIC VERSIONS OF THIS DRAWING TO
 DETERMINE DIMENSIONS UNLESS SPECIFICALLY
 AUTHORISED BY MICHAEL SPARKS ASSOCIATES
 IF USING AN ELECTRONIC VERSION OF THIS DRAWING
 FIGURED DIMENSIONS TAKE PRECEDENCE AND NOTIFY
 MICHAEL SPARKS ASSOCIATES OF ANY DISCREPANCIES

ENSURE SEALING OF ALL JUNCTIONS TO COMPLY WITH PART L.

NOTE:
 ROOF AND WALL CLADDING TO BE DESIGNED BY SPECIALIST
 CONTRACTOR.
 CLADDING DETAILS TO BE READ IN CONJUNCTION WITH THE
 SPECIFICATION AND ALL RELEVANT BRITISH STANDARDS.
 INCLUDE VAPOUR BARRIER TAPE AROUND ALL OPENINGS AND
 JUNCTIONS.


ALL DIMENSIONS TO BE CHECKED ON SITE.
 STEEL COLUMN SIZES TO BE CONFIRMED AND TOLERANCES TO BE AGREED.

- 6mm CLEAR LOW E-GLASS TOUGHENED
16mm ARGON SPACER COMPRISING 90% ARGON
6.4mm SOFT COAT LAMINATED
- B 6mm SATIN SANDBLASTED TOUGHENED
16mm ARGON SPACER COMPRISING 90% ARGON
6.4mm SOFT COAT LAMINATED
- 1 6.8mm VANCEVA LAMINATED BLUE GLASS TOUGHENED
PANE - REF **TRUE BLUE**
16mm ARGON SPACER COMPRISING 90% ARGON
6mm CLEAR LOW E-GLASS TOUGHENED
- 2 6.8mm VANCEVA LAMINATED BLUE GLASS TOUGHENED
PANE - REF **AQUAMARINE**
16mm ARGON SPACER COMPRISING 90% ARGON
6mm CLEAR LOW E-GLASS TOUGHENED
- 3 6.8mm VANCEVA LAMINATED BLUE GLASS TOUGHENED
PANE - REF **SAPPHIRE**
16mm ARGON SPACER COMPRISING 90% ARGON
6mm CLEAR LOW E-GLASS TOUGHENED
- 4 6.8mm VANCEVA LAMINATED BLUE GLASS TOUGHENED
PANE - REF **6166**
16mm ARGON SPACER COMPRISING 90% ARGON
6mm CLEAR LOW E-GLASS TOUGHENED

AS BUILT

THIS "AS-BUILT" DRAWING IS BASED ON INFORMATION SUPPLIED TO MICHAEL SPARKS ASSOCIATES BY MC LAREN CONSTRUCTION AND INCORPORATES INSTRUCTIONS AND OTHER DESIGN INFORMATION GIVEN TO MC LAREN CONSTRUCTION DIRECTLY BY OTHERS

A	25.03.2009	Refer to sub-contractors drawings for specialist details This supercedes drawing no: 2716/RE/309	JH	NSC
REV	DATE	NOTE	DRAW	CHK

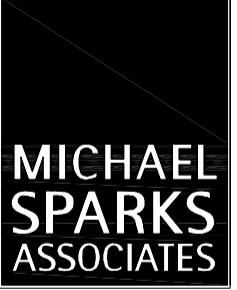

MICHAEL SPARKS ASSOCIATES

CHARTERED ARCHITECTS
 11 PLATO PLACE
 STATIONS ROAD
 LONDON SW6 4TU
 TELEPHONE 020 7736 6162
 FAX 020 7736 3896
 www.msa-architects.co.uk

FROGMORE

TITLE
CROSSWAYS, DARTFORD

DRAWING
WATERSIDE COURT OFFICE 9 ELEVATIONS

CLIENT
FROGMORE

DATE	SCALE	DRAWN
MARCH 2009	1:100 @ A1	JH
	STATUS	CHECKED
	AS BUILT	NSC
DRAWING NUMBER		
2716 / AB/ 1110 A		